


1 LOCATION OF WATER WELL: Fraction NE 1/4 NE 1/4 NE 1/4 Section Number 24 Township Number T 8 S Range Number R 8 E/W  
 County: Pott

Distance and direction from nearest town or city street address of well if located within city? 5 miles south of Westminster on Plush Rd. 2 miles west on Adnatha Road

2 WATER WELL OWNER: Leonard J. Ebert  
 RR#, St. Address, Box #: Box 1 501 N. First Street  
 City, State, ZIP Code: Westmorland, KS 66549  
 Board of Agriculture, Division of Water Resources  
 Application Number:

3 LOCATE WELL'S LOCATION WITH AN "X" IN SECTION BOX:

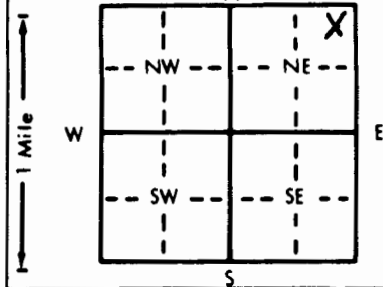

4 DEPTH OF COMPLETED WELL: 120 ft. ELEVATION:  
 Depth(s) Groundwater Encountered 1. 84 ft. 2. ft. 3. ft.  
 WELL'S STATIC WATER LEVEL: 75 ft. below land surface measured on mo/day/yr  
 Pump test data: Well water was ft. after hours pumping gpm  
 Est. Yield 20 gpm: Well water was ft. after hours pumping gpm  
 Bore Hole Diameter: 9" in. to 120 ft., and in. to ft.  
 WELL WATER TO BE USED AS:  
 Domestic 3 Feedlot 6 Oil field water supply 9 Dewatering 12 Other (Specify below)  
 2 Irrigation 4 Industrial 7 Lawn and garden only 10 Monitoring well  
 Was a chemical/bacteriological sample submitted to Department? Yes No; If yes, mo/day/yr sample was submitted  
 Water Well Disinfected?  Yes No

5 TYPE OF BLANK CASING USED:  
 1 Steel 3 RMP (SR) 6 Asbestos-Cement 9 Other (specify below) Welded  
 2 PVC 4 ABS 7 Fiberglass Threaded

Blank casing diameter: 5 in. to 100 ft., Dia. in. to ft., Dia. in. to ft.  
 Casing height above land surface: 2 in., weight Sch 40 lbs./ft. Wall thickness or gauge No.

TYPE OF SCREEN OR PERFORATION MATERIAL:  
 1 Steel 3 Stainless steel 5 Fiberglass 8 RMP (SR) 11 Other (specify)  
 2 Brass 4 Galvanized steel 6 Concrete tile 9 ABS 12 None used (open hole)

SCREEN OR PERFORATION OPENINGS ARE:  
 1 Continuous slot 3 Mill slot 25/1000's 5 Gauzed wrapped 8 Saw cut 11 None (open hole)  
 2 Louvered shutter 4 Key punched 6 Wire wrapped 9 Drilled holes 10 Other (specify)

SCREEN-PERFORATED INTERVALS: From 100 ft. to 120 ft., From ft. to ft.  
 GRAVEL PACK INTERVALS: From 25 ft. to 120 ft., From ft. to ft.

6 GROUT MATERIAL: 1 Neat cement 2 Cement grout  3 Bentonite 4 Other  
 Grout intervals: From 0 ft. to 25 ft., From ft. to ft., From ft. to ft.

What is the nearest source of possible contamination: None close  
 1 Septic tank 4 Lateral lines 7 Pit privy 10 Livestock pens 14 Abandoned water well  
 2 Sewer lines 5 Cess pool 8 Sewage lagoon 11 Fuel storage 15 Oil well/Gas well  
 3 Watertight sewer lines 6 Seepage pit 9 Feedyard 12 Fertilizer storage 16 Other (specify below)  
 13 Insecticide storage

Direction from well? How many feet?

FROM	TO	LITHOLOGIC LOG	FROM	TO	PLUGGING INTERVALS
0	1	Top soil	77	84	Grey Shale
1	10	Brown clay	84	89	Limestone (water)
10	11	Limestone	89	102	Brown Shale
11	20	Brown shale	102	113	Limestone
20	21	Limestone	113	120	Grey Shale
21	42	Tan shale			
42	44	Limestone			
44	49	Grey shale			
49	53	Limestone			
53	58	Tan shale			
58	64	Limestone			
64	68	Brown shale			
68	73	Limestone			
73	75	Grey shale			
75	77	Limestone			

7 CONTRACTOR'S OR LANDOWNER'S CERTIFICATION: This water well was  (1) constructed,  (2) reconstructed, or  (3) plugged under my jurisdiction and was completed on (mo/day/year) 8/28/95 and this record is true to the best of my knowledge and belief. Kansas Water Well Contractor's License No. 451 This Water Well Record was completed on (mo/day/yr) 9/15/95 under the business name of Haldeman Well Drilling by (signature) Craig W. [unclear]