


1 LOCATION OF WATER WELL: County: POTTAWATOMIE Fraction: SE 1/4 NW 1/4 NW 1/4 Section Number: 26 Township Number: T 8 S 8 Range Number: R 8 E/W Distance and direction from nearest town or city street address of well if located within city? From Manhattan go 4 miles North 2 1/2 to Hwy 13 then go North East 4 miles to Mayers Valley Rd + go South East 2 miles to Med Clinic + go 1 mile East

2 WATER WELL OWNER: CARALYN AVINY TOST 3505 STAGCDBACH CIRCLE Manhattan, KS 66503 Board of Agriculture, Division of Water Resources Application Number:

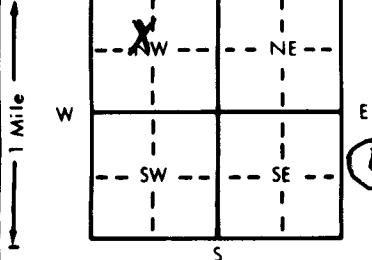

3 LOCATE WELL'S LOCATION WITH AN 'X' IN SECTION BOX: 4 DEPTH OF COMPLETED WELL: Was 23' ft. ELEVATION: ... ft. Depth(s) Groundwater Encountered Was 13' ft. 2. ... ft. 3. ... ft. WELL'S STATIC WATER LEVEL Was 13' ft. below land surface measured on mo/day/yr Pump test data: Well water was ... ft. after ... hours pumping ... gpm Est. Yield ? gpm: Well water was ... ft. after ... hours pumping ... gpm Bore Hole Diameter Was 3' in. to ... ft., and ... in. to ... ft. WELL WATER TO BE USED AS: 5 Public water supply 8 Air conditioning 11 Injection well Was 1 Domestic 3 Feedlot 6 Oil field water supply 9 Dewatering 12 Other (Specify below) 2 Irrigation 4 Industrial 7 Lawn and garden only 10 Monitoring well Was a chemical/bacteriological sample submitted to Department? Yes ... No ... If yes, mo/day/yr sample was submitted Water Well Disinfected? Yes No

5 TYPE OF BLANK CASING USED: 1 Steel 3 RMP (SR) 5 Wrought iron 8 Concrete tile CASING JOINTS: Glued ... Clamped ... 2 PVC 4 ABS Hand Dig 6 Asbestos-Cement 9 Other (specify below) Welded ... 7 Fiberglass Threaded ... Blank casing diameter Was 3' Hand Dig in. to ... ft. Dia ... in. to ... ft. Casing height above land surface Removed 3' Down in., weight ... lbs./ft. Wall thickness or gauge No. TYPE OF SCREEN OR PERFORATION MATERIAL: 1 Steel 3 Stainless steel 5 Fiberglass 7 PVC 10 Asbestos-cement 2 Brass 4 Galvanized steel 6 Concrete tile 8 RMP (SR) 11 Other (specify) Was ROCK Hand Dig 12 None used (open hole) SCREEN OR PERFORATION OPENINGS ARE: 1 Continuous slot 3 Mill slot 5 Gauzed wrapped 8 Saw cut 11 None (open hole) 2 Louvered shutter 4 Key punched 6 Wire wrapped 9 Drilled holes NA 7 Torch cut 999 10 Other (specify) SCREEN-PERFORATED INTERVALS: From 999 ft. to 999 ft., From ... ft. to ... ft. GRAVEL PACK INTERVALS: From ... ft. to ... ft., From ... ft. to ... ft.

6 GROUT MATERIAL: 1 Neat cement 2 Cement grout 3 Bentonite 4 Other Grout Intervals: From 3 ft. to 4 ft., From 13 ft. to 13 ft., From ... ft. to ... ft. What is the nearest source of possible contamination: 1 Septic tank 4 Lateral lines None Close 7 Pit privy 10 Livestock pens 14 Abandoned water well 2 Sewer lines 5 Cess pool 8 Sewage lagoon 12 Fertilizer storage 15 Oil well/Gas well 3 Watertight sewer lines 6 Seepage pit 9 Feedyard 13 Insecticide storage 16 Other (specify below) Direction from well? How many feet?

FROM	TO	LITHOLOGIC LOG	FROM	TO	PLUGGING INTERVALS
0	3	COMPACTED CLAY			
3	4	BENTONITE			
4	12	SANDY CLAY			
12	13	BENTONITE			
13	23	CHLORINATED SANDS + GROUT			

7 CONTRACTOR'S OR LANDOWNER'S CERTIFICATION: This water well was (1) constructed, (2) reconstructed, or (3) plugged under my jurisdiction and was completed on (mo/day/year) 12/18/98 and this record is true to the best of my knowledge and belief. Kansas Water Well Contractor's License No. 451 This Water Well Record was completed on (mo/day/yr) 12/28/98 under the business name of Holdeman Well Drilling by (signature) CWD/PT