

USE TYPEWRITER OR BALL POINT PEN-PRESS FIRMLY, PRINT CLEARLY.

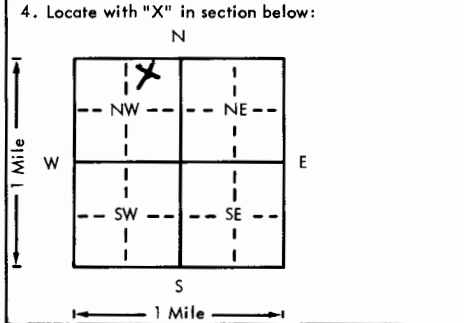
WATER WELL RECORD
KSA 82a-1201-1215

Kansas Department of Health and Environment-Division of Environment
(Water well Contractors)
Topeka, Kansas 66620

NE 1/4 NE 1/4 NW 1/4

1. Location of well: County Pottawatomie Fraction NW 1/4 Section number 17-18 Township number T 8 S R 80W Range number 80W

2. Distance and direction from nearest town or city: 3E 1 1/2 S 1/2 W 2S 1/2 East olsburg South side 3. Owner of well: Lea Lear Brock
Street address of well location if in city: olsburg Kansas
City, state, zip code: olsburg Kansas

4. Locate with "X" in section below: Sketch map: 

6. Bore hole dia. 10 in. Completion date 5-19-77
Well depth 111 ft.

7. Cable tool Rotary Driven Dug
 Hollow rod Jetted Bored Reverse rotary

8. Use: Domestic Public supply Industry
 Irrigation Air conditioning Stock
 Lawn Oil field water Other

9. Casing: Material PVC Height: Above or below
Threaded Welded Surface 2 1/2 in.
RMP PVC Weight lbs./ft.
Dia. 3 in. to 111 ft. depth; Wall Thickness: inches or
Dia. in. to ft. depth; Gauge No. sch 40

5. Type and color of material	From	To
top soil	0	4
Rock ledge lime	18	32
Shale Blue	32	56
Rock Flint	56	59
))	59	63
) Limestone	63	73
shale Soft	73	74
))	74	81
Rock Blue Limestone	81	91
Rock Soft yellow lime	91	101
Rock Blue	101	111

10. Screen: Manufacturer's name MPT
Type P.V.C. Dia. 5 1/4
Slot/gauge .040 Length 40
Set between 111 ft. and 91 ft.
91 ft. and 41 ft.
Gravel pack? Size range of material 1/4"

11. Static water level: 86 ft. below land surface Date 5-19-77
No./day/yr. 77

12. Pumping level below land surfaces:
____ ft. after ____ hrs. pumping ____ g.p.m.
____ ft. after ____ hrs. pumping ____ g.p.m.
Estimated maximum yield 14 g.p.m.

13. Water sample submitted: 5-19-77 mg./day/yr.
 Yes No Date

14. Well head completion: NA
 Pitless adapter ____ inches above grade

15. Well grouted?
With: Neat cement Bentonite Concrete
Depth: From 15 ft. to 4 ft.

16. Nearest source of possible contamination: 75 ft. Direction north Type Cow lot
Well disinfected upon completion? Yes No

17. Pump: Not installed
Manufacturer's name _____
Model number _____ HP _____ Volts _____
Length of drop pipe _____ ft. capacity _____ g.p.m.
Type:
 Submersible Turbine
 Jet Reciprocating
 Centrifugal Other

18. Elevation: _____
19. Remarks: 135 0'

20. Water well contractor's certification:
This well was drilled under my jurisdiction and this report is true to the best of my knowledge and belief.
Strader Drilling Co 237
Business name Blue Rapids License No. _____
Address Harold Strader Date 5-19-77
Signed _____ Authorized representative

Forward the white, blue and pink copies to the Department of Health and Environment

Form WWC-5