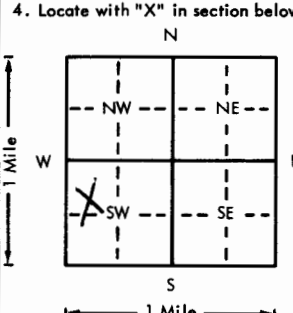


USE TYPEWRITER OR BALL POINT PEN-PRESS FIRMLY, PRINT CLEARLY.

WATER WELL RECORD
KSA 82a-1201-1215

Kansas Department of Health and Environment-Division of Environment
(Water well Contractors)
Topeka, Kansas 66620

1. Location of well: County <u>Pottawatomie</u> Fraction <u>SW 1/4 NW 1/4 SW 1/4</u> Section number <u>11</u> Township number <u>T 8 S 5 R 8 E</u> Range number <u>E/W</u>	
2. Distance and direction from nearest town or city: <u>4 3/4 mi. South</u> Street address of well location if in city: <u>of Fostonia</u>	
3. Owner of well: <u>Hazel Frank</u> R.R. or street: <u>Westmorland Hwy</u> City, state, zip code: <u>Westmorland Kans</u>	
4. Locate with "X" in section below: Sketch map: 	
6. Bore hole dia. <u>10</u> in. Completion date <u>8-6-76</u> Well depth <u>75</u> ft.	
7. <input checked="" type="checkbox"/> Cable tool <input type="checkbox"/> Rotary <input type="checkbox"/> Driven <input type="checkbox"/> Dug <input type="checkbox"/> Hollow rod <input type="checkbox"/> Jetted <input type="checkbox"/> Bored <input type="checkbox"/> Reverse rotary	
8. Use: <input checked="" type="checkbox"/> Domestic <input type="checkbox"/> Public supply <input type="checkbox"/> Industry <input type="checkbox"/> Irrigation <input type="checkbox"/> Air conditioning <input type="checkbox"/> Stack <input type="checkbox"/> Lawn <input type="checkbox"/> Oil field water <input type="checkbox"/> Other	
9. Casing: Material <u>PVC</u> Height: <u>Above</u> or below <u>98</u> in. Threaded <input type="checkbox"/> Welded <input type="checkbox"/> Surface <u>98</u> in. RMP <input type="checkbox"/> PVC <input checked="" type="checkbox"/> Weight <u>258 lb/100</u> Dia. <u>5</u> in. to <u>75</u> ft. depth Wall thickness: <u>3/8</u> inches or <u>2 1/2</u> inches Dia. <u>5</u> in. to <u>75</u> ft. depth gage No. <u>92640</u>	
10. Screen: Manufacturer's name <u>Pumped</u> Type <u>PVC</u> Dia. <u>1 1/2</u> Slot/gauge <u>0.50</u> Length <u>40</u> Set between <u>35</u> ft. and <u>75</u> ft. Gravel pack? <input checked="" type="checkbox"/> Size range of material: <u>1/8" X 1/4"</u>	
11. Static water level: <u>30</u> ft. below land surface Date <u>8-6-76</u> mo./day/yr.	
12. Pumping level below land surfaces: <u>15</u> ft. after <u>1</u> hrs. pumping <u>2.0</u> g.p.m. <u>30</u> ft. after <u>1</u> hrs. pumping <u>2.0</u> g.p.m. Estimated maximum yield <u>2.0</u> g.p.m.	
13. Water sample submitted: <u>Yes</u> <input checked="" type="checkbox"/> <u>No</u> <input type="checkbox"/> Date <u>8-6-76</u> mo./day/yr.	
14. Well head completion: <u>NA</u> Pitless adapter <u>NA</u> Inches above grade	
15. Well grouted? <input checked="" type="checkbox"/> With: <u>Neat cement</u> <input type="checkbox"/> <u>Bentonite</u> <input checked="" type="checkbox"/> <u>Concrete</u> <input type="checkbox"/> Depth: From <u>15</u> ft. to <u>4</u> ft.	
16. Nearest source of possible contamination: <u>450</u> ft. Direction <u>east</u> Type <u>Creek</u> Well disinfected upon completion? <input checked="" type="checkbox"/> Yes <input type="checkbox"/> No	
17. Pump: <input checked="" type="checkbox"/> Not installed Manufacturer's name <u>NA</u> Model number <u>NA</u> HP <u>NA</u> Volts <u>NA</u> Length of drop pipe <u>NA</u> ft. capacity <u>NA</u> g.p.m. Type: <input type="checkbox"/> Submersible <input type="checkbox"/> Turbine <input type="checkbox"/> Jet <input type="checkbox"/> Reciprocating <input type="checkbox"/> Centrifugal <input type="checkbox"/> Other	
18. Elevation: Topography: <input type="checkbox"/> Hill <input checked="" type="checkbox"/> Slope <input type="checkbox"/> Upland <input type="checkbox"/> Valley	
19. Remarks: (Use a second sheet if needed)	
20. Water well contractor's certification: This well was drilled under my jurisdiction and this report is true to the best of my knowledge and belief. <u>Stader Drilling Co</u> Business name <u>Blue Rapids</u> License No. <u>237</u> Address <u>Harold Stader</u> Signed <u>Harold Stader</u> Date <u>8-6-76</u> Authorized representative	

Forward the white, blue and pink copies to the Department of Health and Environment

Form WWC-5