


1 LOCATION OF WATER WELL: Fraction SW 1/4 NE 1/4 Section Number 16 Township Number T 8 S Range Number R 8 E/W  
 County: Pottawatomie  
 Distance and direction from nearest town or city street address of well if located within city? 7 miles on Highway 14 60 yards from Tuth Creek Lake

2 WATER WELL OWNER: Larry Wickstrom 1-457-3549  
 RR#, St. Address, Box #: RR  
 City, State, ZIP Code: Westmoreland, Kansas 66549  
 Board of Agriculture, Division of Water Resources  
 Application Number:

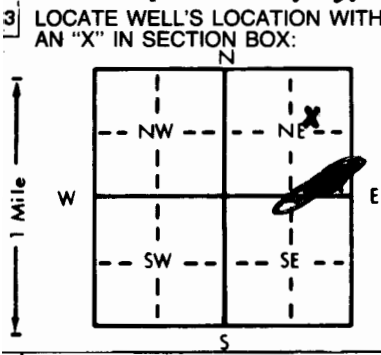

4 DEPTH OF COMPLETED WELL: 60 ft. ELEVATION:  
 Depth(s) Groundwater Encountered 1. 29 ft. 2. ft. 3. ft.  
 WELL'S STATIC WATER LEVEL: 26 ft. below land surface measured on mo/day/yr  
 Pump test data: Well water was ft. after hours pumping gpm  
 Est. Yield 10 gpm: Well water was ft. after hours pumping gpm  
 Bore Hole Diameter: 8 in. to 60 ft., and in. to ft.  
 WELL WATER TO BE USED AS:  
 1 Domestic  3 Feedlot  6 Oil field water supply  9 Dewatering  12 Other (Specify below)  
 2 Irrigation  4 Industrial  7 Lawn and garden only  10 Monitoring well  
 Was a chemical/bacteriological sample submitted to Department? Yes.....No..... If yes, mo/day/yr sample was submitted  
 Water Well Disinfected?  Yes  No

5 TYPE OF CASING USED:  
 1 Steel  3 RMP (SR)  5 Wrought iron  8 Concrete tile  CASING JOINTS:  Glued  Clamped  
 2 PVC  4 ABS  6 Asbestos-Cement  9 Other (specify below)  Welded  Threaded  
 Blank casing diameter: 5 in. to 40 ft., Dia. in. to ft., Dia. in. to ft.  
 Casing height above land surface: 2 in., weight Sch 40 lbs./ft. Wall thickness or gauge No.  
 TYPE OF SCREEN OR PERFORATION MATERIAL:  
 1 Steel  3 Stainless steel  5 Fiberglass  7 PVC  10 Asbestos-cement  
 2 Brass  4 Galvanized steel  6 Concrete tile  9 ABS  11 Other (specify)  
 12 None used (open hole)  
 SCREEN OR PERFORATION OPENINGS ARE:  
 1 Continuous slot  3 Mill slot 31/1000  5 Gauzed wrapped  8 Saw cut  11 None (open hole)  
 2 Louvered shutter  4 Key punched  6 Wire wrapped  9 Drilled holes  
 7 Torch cut  10 Other (specify)  
 SCREEN-PERFORATED INTERVALS: From 40 ft. to 60 ft., From ft. to ft.  
 GRAVEL PACK INTERVALS: From 20 ft. to 60 ft., From ft. to ft.

6 GROUT MATERIAL:  1 Neat cement  2 Cement grout  3 Bentonite  4 Other  
 Grout Intervals: From 0 ft. to 20 ft., From ft. to ft. From FM. dipping ft. to ft.  
 What is the nearest source of possible contamination: Lateral lines  
 1 Septic tank  4 Lateral lines  7 Pit privy  10 Livestock pens  14 Abandoned water well  
 2 Sewer lines  5 Cess pool  8 Sewage lagoon  11 Fuel storage  15 Oil well/Gas well  
 3 Watertight sewer lines  6 Seepage pit  9 Feedyard  12 Fertilizer storage  16 Other (specify below)  
 13 Insecticide storage  
 Direction from well? North How many feet? 70

FROM	TO	LITHOLOGIC LOG	FROM	TO	PLUGGING INTERVALS
0	3	Top Soil	53	56	Limstone
3	7	Brown Clay	56	60	Gray shale
7	9	Limstone			
9	12	Yellow shale			
12	18	Brown shale			
18	21	Limstone			
21	23	Greenish shale			
23	25	Limstone			
25	29	Greenish shale			
29	32	Limstone (water)			
32	39	Gray shale			
39	42	Brown shale			
42	45	Gray shale			
45	49	Limstone			
49	53	Gray shale			

7 CONTRACTOR'S OR LANDOWNER'S CERTIFICATION: This water well was  (1) constructed,  (2) reconstructed, or  (3) plugged under my jurisdiction and was completed on (mo/day/year) 3/16/90 and this record is true to the best of my knowledge and belief. Kansas Water Well Contractor's License No. 451 This Water Well Record was completed on (mo/day/yr) 4/21/90 under the business name of Holdman Well Drilling by (signature) Craig D. CWO/PA

INSTRUCTIONS: Use typewriter or ball point pen. PLEASE PRESS FIRMLY and PRINT clearly. Please fill in blanks, underline or circle the correct answers. Send top three copies to Kansas Department of Health and Environment, Bureau of Water Protection, Topeka, Kansas 66620-7320. Telephone: 913-296-5514. Send one to WATER WELL OWNER and retain one for your records.