


1] LOCATION OF WATER WELL: County: POTT Fraction: SE 1/4 SE 1/4 SE 1/4 Section Number: 26 Township Number: T 8 S Range Number: R 8 EW

Distance and direction from nearest town or city street address of well if located within city? From Flush 60 North 3/4 of a mile to Myers Valley Rd + Turn West 60 2 miles to Lake Elbow + Turn North + 60 1/2 mile

2] WATER WELL OWNER: Eugene H. Kautson  
 RR#, St. Address, Box #: P.O. Box 385  
 City, State, ZIP Code: Marquette, KS 66502  
 Board of Agriculture, Division of Water Resources  
 Application Number:

3] LOCATE WELL'S LOCATION WITH AN "X" IN SECTION BOX:

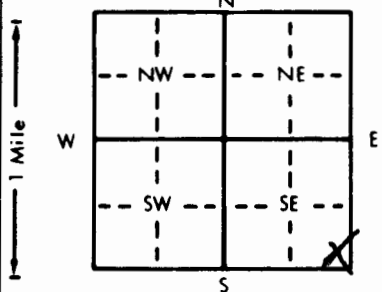

4] DEPTH OF COMPLETED WELL: 80 ft. ELEVATION:

Depth(s) Groundwater Encountered 1. 54 ft. 2. ft. 3. ft.  
 WELL'S STATIC WATER LEVEL 50 ft. below land surface measured on mo/day/yr  
 Pump test data: Well water was ft. after hours pumping gpm  
 Est. Yield 2.5 gpm: Well water was ft. after hours pumping gpm  
 Bore Hole Diameter 9 in. to 80 ft., and in. to ft.  
 WELL WATER TO BE USED AS:  
 1 Domestic  3 Feedlot  6 Oil field water supply  9 Dewatering  12 Other (Specify below)  
 2 Irrigation  4 Industrial  7 Lawn and garden only  10 Monitoring well  
 Was a chemical/bacteriological sample submitted to Department? Yes No; If yes, mo/day/yr sample was submitted Water Well Disinfected?  Yes  No

5] TYPE OF BLANK CASING USED:  1 Steel  3 RMP (SR)  5 Wrought iron  8 Concrete tile CASING JOINTS:  Glued  Clamped

2 PVC  4 ABS  6 Asbestos-Cement  9 Other (specify below)  Welded  
 7 Fiberglass  Threaded  
 Blank casing diameter 5 in. to 60 ft., Dia in. to ft., Dia in. to ft.  
 Casing height above land surface 2' in., weight 50 lbs./ft. Wall thickness or gauge No.

TYPE OF SCREEN OR PERFORATION MATERIAL:  
 1 Steel  3 Stainless steel  5 Fiberglass  7 PVC  10 Asbestos-cement  
 2 Brass  4 Galvanized steel  6 Concrete tile  8 RMP (SR)  11 Other (specify)  
 12 None used (open hole)

SCREEN OR PERFORATION OPENINGS ARE: 25 1000<sup>s</sup>  3 Mill slot  5 Gauzed wrapped  8 Saw cut  11 None (open hole)  
 1 Continuous slot  6 Wire wrapped  9 Drilled holes  
 2 Louvered shutter  4 Key punched  7 Torch cut  10 Other (specify)

SCREEN-PERFORATED INTERVALS: From 60 ft. to 80 ft., From ft. to ft.  
 GRAVEL PACK INTERVALS: From 20 ft. to 80 ft., From ft. to ft.

6] GROUT MATERIAL:  1 Neat cement  2 Cement grout  3 Bentonite  4 Other  
 Grout Intervals: From 0 ft. to 20 ft., From ft. to ft., From ft. to ft.

What is the nearest source of possible contamination: None Close Pit privy  
 1 Septic tank  4 Lateral lines  8 Sewage lagoon  10 Livestock pens  14 Abandoned water well  
 2 Sewer lines  5 Cess pool  9 Feedyard  11 Fuel storage  15 Oil well/Gas well  
 3 Watertight sewer lines  6 Seepage pit  12 Fertilizer storage  16 Other (specify below)  
 13 Insecticide storage

Direction from well? How many feet?

FROM	TO	LITHOLOGIC LOG	FROM	TO	PLUGGING INTERVALS
0	1	Top Soil			
1	2	Brown Clay			
2	6	Limestone			
6	26	Brown Shale			
26	28	Limestone			
28	30	Grey Shale			
30	31	Limestone			
31	49	Tan Shale			
49	51	Limestone			
51	54	Brown Shale			
54	59	Limestone			
59	80	DARK Grey Shale			

7] CONTRACTOR'S OR LANDOWNER'S CERTIFICATION: This water well was  (1) constructed, (2) reconstructed, or (3) plugged under my jurisdiction and was completed on (mo/day/year) 6/3/93 and this record is true to the best of my knowledge and belief. Kansas Water Well Contractor's License No. 451 This Water Well Record was completed on (mo/day/yr) 6/25/93 under the business name of Haldeman Well Drilling by (signature) Craig J. Cudde