

USE TYPEWRITER OR BALL POINT PEN—PRESS FIRMLY, PRINT CLEARLY.

T R EW sec 1/4 1/4 1/4 No.

WATER WELL RECORD  
KSA 82a-1201-1215

Kansas State Dept. Of Health  
(Water Well Contractors)  
Forbes-Bldg. 740  
Topeka, Kansas 66620


NE 1/4 NE 1/4 N.W 1/4

1 Location of well:	County POTT	Township name	Fraction NE CORNER NW 1/4	Section number 28	Town number 8	Range number 8 E of 6 PM
---------------------	----------------	---------------	------------------------------------	----------------------	------------------	-----------------------------

Distance and direction from nearest town or city:  
10 MILES EAST NORTH MANHATTAN

Owner of well: BILL DAUGHERTY  
Address: 2305 PONTIAC ST  
MANHATTAN, KANSAS

Locate with "X" in section below:

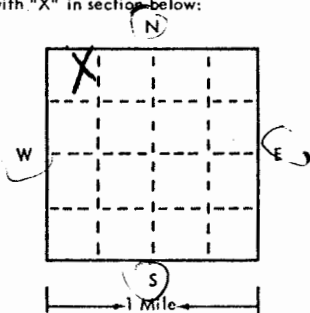

Sketch map:

4 Well depth: 83 ft. Date of completion 2-28-76  
Well diameter 8 in.

5  Cable tool  Rotary  Driven  Dug  
 Hollow rod  Jetted  Bored  Reverse rotary

6 Use:  Domestic  Public supply  Industry  
 Irrigation  Air conditioning  Commercial  
 Test well

7 Casing: Material PLASTIC Height: above/below  
Threaded  Welded  Surface 14 in.  
Diam. 5 in. to 83 ft. depth Drive shoe?  Yes  No

2	Type and color of material	From	To
	TOP SOIL	0	5
	YELLOW LIME ROCK	5	20
	RED CLAY	20	25
	YELLOW LIME ROCK	25	60
	BLUE SHALE	60	83

8 Screen: Pumped  
Manufacturer PVA Dia 5  
Type PLASTIC Slot 40 Length 20  
Set between 83 ft. and 69 ft.  
Fittings: Gravel pack  Yes  No Size range of material 1/8

9 Static water level: 35 ft. below land surface Date 2-28-76

10 Pumping level below land surfaces: BUCKETED  
ft. after hrs. pumping g.p.m.  
ft. after hrs. pumping g.p.m.  
Estimated maximum yield 10 g.p.m.

11 Water sample submitted:  Yes  No Date 2-28-76

12 Well head completion: N/A  
 Pitless adapter  Inches above grade

13 Well grouted?  Yes  No  
 Neat cement  Bentonite  Cemented  
Depth: From 20 ft. to 10 ft.

14 Nearest source of possible contamination:  
ft. 25 Direction EAST Type DITCH  
Well disinfected upon completion?  Yes  No

15 Pump:  Not installed  
Manufacturer's name \_\_\_\_\_  
Model number \_\_\_\_\_ HP \_\_\_\_\_ Volts \_\_\_\_\_  
Length of drop pipe \_\_\_\_\_ ft. capacity \_\_\_\_\_ g.p.m.  
Type:  Submersible  Turbine  
 Jet  Reciprocating  
 Centrifugal  Other

16 Remarks: elevation

- Topography:
- Hill
  - Slope
  - Upland
  - Valley

17 Water well contractor's certification:  
This well was drilled under my jurisdiction and this report is true to the best of my knowledge and belief.

Strader Drilling Co. 237  
Business name License No.  
Address Blue Rapids  
Signed Harold Strader Date 2-28-76  
Authorized representative