


1 LOCATION OF WATER WELL: County: Pottawatomie Fraction: SW 1/4 SW 1/4 SE 1/4 Section Number: 10 Township Number: T 8 S Range Number: R 9 E/W

Distance and direction from nearest town or city street address of well if located within city?  
2 S 1/2 E of Westmoreland

2 WATER WELL OWNER: Ken Lamb  
 RR#, St. Address, Box #: Rt. 1 Box 37C Board of Agriculture, Division of Water Resources  
 City, State, ZIP Code: Westmoreland, KS 66549 Application Number:

3 LOCATE WELL'S LOCATION WITH AN "X" IN SECTION BOX:

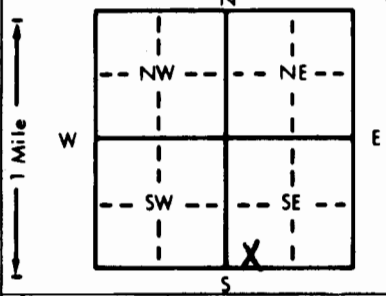

4 DEPTH OF COMPLETED WELL: 120 ft. ELEVATION:

Depth(s) Groundwater Encountered 1. 85' ft. 2. ft. 3. ft.  
 WELL'S STATIC WATER LEVEL 56' ft. below land surface measured on mo/day/yr 7-06-88  
 Pump test data: Well water was ft. after hours pumping gpm  
 Est. Yield 10 gpm: Well water was ft. after hours pumping gpm  
 Bore Hole Diameter: 8 3/4" in. to ft., and in. to ft.  
 WELL WATER TO BE USED AS:  
 5 Public water supply 8 Air conditioning 11 Injection well  
1 Domestic 3 Feedlot 6 Oil field water supply 9 Dewatering 12 Other (Specify below)  
 2 Irrigation 4 Industrial 7 Lawn and garden only 10 Observation well  
 Was a chemical/bacteriological sample submitted to Department? Yes No X; If yes, mo/day/yr sample was submitted Water Well Disinfected? Yes X No

5 TYPE OF BLANK CASING USED: 5 Wrought iron 8 Concrete tile CASING JOINTS: Glued X Clamped  
 1 Steel 3 RMP (SR) 6 Asbestos-Cement 9 Other (specify below) Welded  
 2 PVC 4 ABS 7 Fiberglass Threaded

Blank casing diameter 5" in. to 0-80 ft., Dia. 5" in. to 95-119 ft., Dia. in. to ft.  
 Casing height above land surface 24" in., weight 2.82 lbs./ft. Wall thickness or gauge No. 258

TYPE OF SCREEN OR PERFORATION MATERIAL:  
 1 Steel 3 Stainless steel 5 Fiberglass 7 PVC 10 Asbestos-cement  
 2 Brass 4 Galvanized steel 6 Concrete tile 8 RMP (SR) 11 Other (specify)  
 12 None used (open hole)

SCREEN OR PERFORATION OPENINGS ARE:  
 1 Continuous slot 3 Mill slot 5 Gauzed wrapped 8 Saw cut 11 None (open hole)  
 2 Louvered shutter 4 Key punched 6 Wire wrapped 9 Drilled holes  
 7 Torch cut 10 Other (specify)

SCREEN-PERFORATED INTERVALS: From 80 ft. to 95 ft., From ft. to ft.  
 From 119 ft. to 120 ft., From ft. to ft.  
 GRAVEL PACK INTERVALS: From 24 ft. to 120 ft., From ft. to ft.  
 From ft. to ft., From ft. to ft.

6 GROUT MATERIAL: 1 Neat cement 2 Cement grout 3 Bentonite 4 Other  
 Grout Intervals: From 4 ft. to 24 ft., From ft. to ft., From ft. to ft.

What is the nearest source of possible contamination:  
 1 Septic tank 4 Lateral lines 7 Pit privy 10 Livestock pens 14 Abandoned water well  
 2 Sewer lines 5 Cess pool 8 Sewage lagoon 11 Fuel storage 15 Oil well/Gas well  
 3 Watertight sewer lines 6 Seepage pit 9 Feedyard 12 Fertilizer storage 16 Other (specify below)  
 13 Insecticide storage  
 Direction from well? NE How many feet? 150

FROM	TO	LITHOLOGIC LOG	FROM	TO	LITHOLOGIC LOG
0	4	Clay-Brown	83	86	Limestone-Yellow-Loose
4	5	Limestone-Yellow	86	120	Shale-Grey
5	8	Shale-Yellow			
8	9	Limestone-Yellow			
9	18	Shale-Yellow			
18	27	Limestone-Yellow			
27	32	Shale-Yellow			
32	37	Limestone-Yellow			
37	47	Shale-Yellow			
47	57	Limestone-Yellow			
57	59	Shale-Yellow			
59	68	Shale-Grey			
68	73	Limestone-Yellow			
73	83	Shale-Yellow			

7 CONTRACTOR'S OR LANDOWNER'S CERTIFICATION: This water well was (1) constructed, (2) reconstructed, or (3) plugged under my jurisdiction and was completed on (mo/day/year) 7-06-88 and this record is true to the best of my knowledge and belief. Kansas Water Well Contractor's License No. 182. This Water Well Record was completed on (mo/day/yr) 7-27-88 under the business name of Strader Drilling Co., Inc. by (signature) [Signature]

INSTRUCTIONS: Use typewriter or ball point pen. PLEASE PRESS FIRMLY and PRINT clearly. Please fill in blanks, underline or circle the correct answers. Send top three copies to Kansas Department of Health and Environment, Bureau of Water Protection, Topeka, Kansas 66620-7320, Telephone: 913-862-9360. Send one to WATER WELL OWNER and retain one for your records.