


1 LOCATION OF WATER WELL: County: Pott Fraction: NE 1/4 NE 1/4 NW 1/4 Section Number: 14 Township Number: T 8 S Range Number: R 9 E

Distance and direction from nearest town or city street address of well if located within city? From Westmopland Co 2 miles South on Highway 99

2 WATER WELL OWNER: Otis Boardman
 RR#, St. Address, Box #: P.O. Box 276
 City, State, ZIP Code: Wamego, KS 66547
 Board of Agriculture, Division of Water Resources
 Application Number:

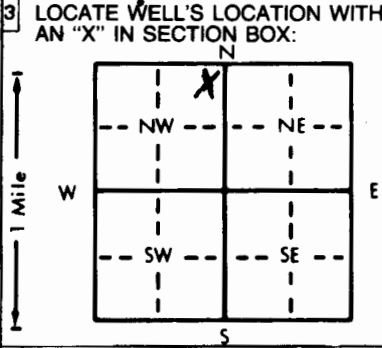

4 DEPTH OF COMPLETED WELL: 160 ft. ELEVATION: _____ ft.
 Depth(s) Groundwater Encountered: 1. 127 ft. 2. _____ ft. 3. _____ ft.
 WELL'S STATIC WATER LEVEL: 90 ft. below land surface measured on mo/day/yr
 Pump test data: Well water was _____ ft. after _____ hours pumping _____ gpm
 Est. Yield: 157 gpm; Well water was _____ ft. after _____ hours pumping _____ gpm
 Bore Hole Diameter: 9 in. to 100 ft., and _____ in. to _____ ft.
 WELL WATER TO BE USED AS:
 1 Domestic (circled) 3 Feedlot 6 Oil field water supply 9 Dewatering 12 Other (Specify below)
 2 Irrigation 4 Industrial 7 Lawn and garden only 10 Monitoring well
 Was a chemical/bacteriological sample submitted to Department? Yes _____ No _____; If yes, mo/day/yr sample was submitted _____
 Water Well Disinfected? Yes (circled) No

5 TYPE OF BLANK CASING USED:
 1 Steel 3 RMP (SR) 5 Wrought iron 8 Concrete tile CASING JOINTS: Glued (circled) Clamped
 2 PVC (circled) 4 ABS 6 Asbestos-Cement 9 Other (specify below) Welded
 Blank casing diameter: 5 in. to 140 ft., Dia _____ in. to _____ ft., Dia _____ in. to _____ ft.
 Casing height above land surface: 2 in., weight Sch 40 lbs./ft. Wall thickness or gauge No. _____
 TYPE OF SCREEN OR PERFORATION MATERIAL:
 1 Steel 3 Stainless steel 5 Fiberglass 8 RMP (SR) 10 Asbestos-cement
 2 Brass 4 Galvanized steel 6 Concrete tile 9 ABS 11 Other (specify) _____
 12 None used (open hole)
 SCREEN OR PERFORATION OPENINGS ARE: 3 Mill slot (circled) 25/1000's
 1 Continuous slot 5 Gauzed wrapped 8 Saw cut 11 None (open hole)
 2 Louvered shutter 4 Key punched 6 Wire wrapped 9 Drilled holes
 7 Torch cut 10 Other (specify) _____
 SCREEN-PERFORATED INTERVALS: From 140 ft. to 160 ft., From _____ ft. to _____ ft.
 GRAVEL PACK INTERVALS: From 25 ft. to 160 ft., From _____ ft. to _____ ft.

6 GROUT MATERIAL: 1 Neat cement 2 Cement grout 3 Bentonite (circled) 4 Other _____
 Grout Intervals: From 0 ft. to 25 ft., From _____ ft. to _____ ft.
 What is the nearest source of possible contamination: None Close
 1 Septic tank 4 Lateral lines 7 Pit privy 10 Livestock pens 14 Abandoned water well
 2 Sewer lines 5 Cess pool 8 Sewage lagoon 11 Fuel storage 15 Oil well/Gas well
 3 Watertight sewer lines 6 Seepage pit 9 Feedyard 12 Fertilizer storage 16 Other (specify below)
 13 Insecticide storage
 Direction from well? _____ How many feet? _____

FROM	TO	LITHOLOGIC LOG	FROM	TO	PLUGGING INTERVALS
0	2	Top Soil	114	118	Greenish Shale
2	14	Brown Clay	118	122	Limestone
14	19	Limestone	122	127	Tan Shale
19	23	Yellow Shale	127	134	Limestone (Water)
23	41	Greenish Shale	134	136	Yellow Shale
41	44	Brown Shale	136	144	Limestone
44	48	Limestone	144	160	Grey Shale
48	55	Brown Shale			
55	59	Limestone			
59	73	Greenish Shale			
73	78	Limestone			
78	95	Greenish Shale			
95	101	Limestone			
101	111	Brown Shale			
111	114	Limestone			

7 CONTRACTOR'S OR LANDOWNER'S CERTIFICATION: This water well was (1) constructed (2) reconstructed, or (3) plugged under my jurisdiction and was completed on (mo/day/year) 10/3/94 and this record is true to the best of my knowledge and belief. Kansas Water Well Contractor's License No. 451 This Water Well Record was completed on (mo/day/yr) 10/26/94 under the business name of Holdeman Well Drilling by (signature) Craig H. CWD/PE