


1	LOCATION OF WATER WELL:	Fraction	Section Number	Township Number	Range Number
	County: <u>CLAY</u>	<u>SE 1/4 SE 1/4 SW 1/4</u>	<u>9</u>	<u>T-9-S</u>	<u>R-1-E</u> EW

Distance and direction from nearest town or city street address of well if located within city?
ONE MILE EAST + 2 MILES NORTH OF OAKHILL KS

2	WATER WELL OWNER: <u>MARK LUND</u>	Board of Agriculture, Division of Water Resources
	RR #, St. Address, Box #: <u>14360 COUNTY LINE RD</u>	Application Number:
	City, State, ZIP Code: <u>GREEN KS 67447</u>	

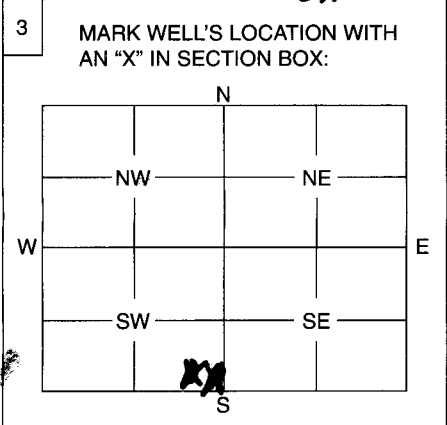

4	DEPTH OF WELL <u>28</u> ft.												
	WELL'S STATIC WATER LEVEL <u>5</u> ft.												
	WELL WAS USED AS:												
	<table border="0"> <tr> <td><input checked="" type="checkbox"/> 1 Domestic</td> <td><input type="checkbox"/> 5 Public Water Supply</td> <td><input type="checkbox"/> 9 Dewatering</td> </tr> <tr> <td><input type="checkbox"/> 2 Irrigation</td> <td><input type="checkbox"/> 6 Oil Field Water Supply</td> <td><input type="checkbox"/> 10 Monitoring Well</td> </tr> <tr> <td><input type="checkbox"/> 3 Feedlot</td> <td><input type="checkbox"/> 7 Domestic (Lawn & Garden)</td> <td><input type="checkbox"/> 11 Injection Well</td> </tr> <tr> <td><input type="checkbox"/> 4 Industrial</td> <td><input type="checkbox"/> 8 Air Conditioning</td> <td><input type="checkbox"/> 12 Other</td> </tr>
	Was a chemical / bacteriological sample submitted to Department? Yes No <input checked="" type="checkbox"/>												
	If yes, mo/day/yr sample was submitted												
	Water Well Disinfected: Yes <input checked="" type="checkbox"/> No												

5 TYPE OF BLANK CASING USED:

1 Steel	3 RMP (SR)	5 Wrought	7 Fiberglass	9 Other (Specify below)
2 PVC	4 ABS	6 Asbestos-Cement	8 Concrete Tile	<u>ROCK</u>

Blank casing diameter 24 in. Was casing pulled? Yes No If yes, how much

Casing height above or below land surface 60 in.

6 GROUT PLUG MATERIAL: 1 Neat cement 2 Cement grout 3 Bentonite 4 Other

Grout Plug Intervals: From 5 ft. to 4.5 ft., From ft. to ft., From to ft.

What is the nearest source of possible contamination:

1 Septic tank	6 Seepage pit	11 Fuel storage	16 Other (specify below)
2 Sewer lines	7 Pit privy	12 Fertilizer storage
3 Watertight sewer lines	8 Sewage lagoon	13 Insecticide storage	
4 Lateral lines	9 Feedyard	14 Abandoned water well	
5 Cess pool	10 Livestock pens	15 Oil well/Gas well	

Direction from well? How many feet?

FROM	TO	PLUGGING MATERIALS
<u>28 ft</u>	<u>5</u>	<u>SAND (7 cu Yds)</u>
<u>5</u>	<u>4.5</u>	<u>BENTONITE 6.28 cu ft</u>
<u>4.5</u>	<u>0</u>	<u>SILT + CLAY</u>

7 CONTRACTOR'S OF LANDOWNER'S CERTIFICATION: This water well was plugged under my jurisdiction and was completed on (mo/day/year) 5-9-05 and this record is true to the best of my knowledge and belief. Kansas Water Well Contractor's License No. 647 This Water Well Record was completed on (mo/day/year) 5-16-05 under the business name of MEL'S PUMP & PLUMBING by (signature) Melvin M. Anderson

INSTRUCTIONS: Use typewriter or ball point pen. Please press firmly and print clearly. Please fill in blanks, underline or circle the correct answers. Send top three copies to Kansas Department of Health and Environment, Bureau of Water, Geology Section, 1000 SW Jackson St., Ste. 420, Topeka, Kansas 66612-1367. Telephone: 785/296-5522. Send one to Water Well Owner and retain one for your records.