


1 LOCATION OF WATER WELL: County: Pottawatomie Fraction SW 1/4 NW 1/4 NW 1/4 Section Number 30 Township Number T 9 S Range Number R 10 E/W

Distance and direction from nearest town or city street address of well if located within city?

1 1/2 west, 1/4 south of Louisville

2 WATER WELL OWNER: Mark Ebert RR#, St. Address, Box #: 6240 Salzer Rd. Board of Agriculture, Division of Water Resources City, State, ZIP Code: Wamego, KS 66547 Application Number:

3 LOCATE WELL'S LOCATION WITH AN "X" IN SECTION BOX:

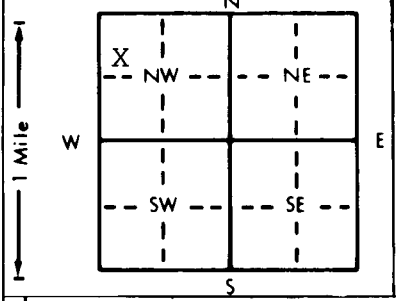

4 DEPTH OF COMPLETED WELL: 70 ft. ELEVATION:

Depth(s) Groundwater Encountered: 1. ft. 2. ft. 3. ft. WELL'S STATIC WATER LEVEL: 8' ft. below land surface measured on mo/day/yr 9-21-95 Pump test data: Well water was ... ft. after ... hours pumping ... gpm Est. Yield: 30 gpm: Well water was ... ft. after ... hours pumping ... gpm Bore Hole Diameter: 12" in. to ... ft., and ... in. to ... ft. WELL WATER TO BE USED AS: 5 Public water supply 8 Air conditioning 11 Injection well 1 Domestic 3 Feedlot 6 Oil field water supply 9 Dewatering 12 Other (Specify below) 2 Irrigation 4 Industrial 7 Lawn and garden only 10 Monitoring well Was a chemical/bacteriological sample submitted to Department? Yes ... No X; If yes, mo/day/yr sample was submitted Water Well Disinfected? Yes X No

5 TYPE OF BLANK CASING USED: 5 Wrought iron 8 Concrete tile CASING JOINTS: Glued X Clamped

1 Steel 3 RMP (SR) 6 Asbestos-Cement 9 Other (specify below) Welded 2 PVC 4 ABS 7 Fiberglass Threaded Blank casing diameter: 5" in. to 0-57 ft., Dia: 5" in. to 67-70 ft., Dia: ... in. to ... ft. Casing height above land surface: 24" in., weight: 2.82 lbs./ft. Wall thickness or gauge No. 258

TYPE OF SCREEN OR PERFORATION MATERIAL: 7 PVC 10 Asbestos-cement 1 Steel 3 Stainless steel 5 Fiberglass 8 RMP (SR) 11 Other (specify) 2 Brass 4 Galvanized steel 6 Concrete tile 9 ABS 12 None used (open hole)

SCREEN OR PERFORATION OPENINGS ARE: 5 Gauzed wrapped 8 Saw cut 11 None (open hole) 1 Continuous slot 3 Mill slot 6 Wire wrapped 9 Drilled holes 2 Louvered shutter 4 Key punched 7 Torch cut 10 Other (specify)

SCREEN-PERFORATED INTERVALS: From 57 ft. to 67 ft., From ... ft. to ... ft. GRAVEL PACK INTERVALS: From 24 ft. to 70 ft., From ... ft. to ... ft.

6 GROUT MATERIAL: 1 Neat cement 2 Cement grout 3 Bentonite 4 Other Grout Intervals: From 4 ft. to 24 ft., From ... ft. to ... ft., From ... ft. to ... ft.

What is the nearest source of possible contamination: 10 Livestock pens 14 Abandoned water well 1 Septic tank 4 Lateral lines 7 Pit privy 11 Fuel storage 15 Oil well/Gas well 2 Sewer lines 5 Cess pool 8 Sewage lagoon 12 Fertilizer storage 16 Other (specify below) 3 Watertight sewer lines 6 Seepage pit 9 Feedyard 13 Insecticide storage Direction from well? west How many feet? 200'

Table with 3 main columns: FROM, TO, LITHOLOGIC LOG. Data rows: 0-1 Top Soil, 1-15 Fine Silt-Brown, 15-60 Fine Sand-Brown, 60-64 FS-CS-Brown, 64-67 FS-CS-Med-Pea Gravel-Brown, 67-70 Shale-Grey.

7 CONTRACTOR'S OR LANDOWNER'S CERTIFICATION: This water well was (1) constructed, (2) reconstructed, or (3) plugged under my jurisdiction and was completed on (mo/day/year) 9-21-95 and this record is true to the best of my knowledge and belief. Kansas Water Well Contractor's License No. 182 This Water Well Record was completed on (mo/day/yr) 10-16-95 under the business name of STRADER DRILLING CO., INC. by (signature) Dale Skron