


1 LOCATION OF WATER WELL: Fraction NEAR CENTER 1/4 SE 1/4 Section Number 24 Township Number T 9 S Range Number R 10 E/W
 County: POTTOWATAMIE

Distance and direction from nearest town or city street address of well if located within city?
FROM WAMEGO EAST ON HWY 24 TO ONAGA RD. , NORTH 3 MILES, WEST 3/4 MILES

2 WATER WELL OWNER: C.A. TESSENDORF
 RR#, St. Address, Box # : 18290 OREGON TRAIL RD. Board of Agriculture, Division of Water Resources
 City, State, ZIP Code : WAMEGO KS. 66547 Application Number: 22068

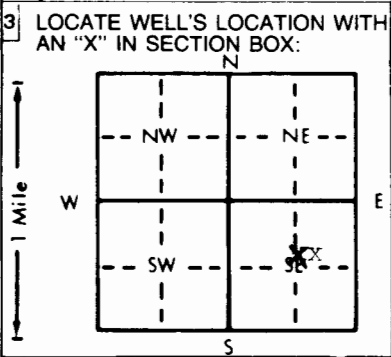

4 DEPTH OF COMPLETED WELL... 78 ft. ELEVATION: _____ ft.
 Depth(s) Groundwater Encountered 1. 29 ft. 2. _____ ft. 3. _____ ft.
 WELL'S STATIC WATER LEVEL 29 ft. below land surface measured on mo/day/yr 7-10-96
 Pump test data: Well water was 36 ft. after 1 hours pumping 800 gpm
 Est. Yield 1200 gpm: Well water was 39 ft. after 2 hours pumping 1200 gpm
 Bore Hole Diameter 32 in. to 78 ft., and _____ in. to _____ ft.
 WELL WATER TO BE USED AS: 5 Public water supply 8 Air conditioning 11 Injection well
 1 Domestic 3 Feedlot 6 Oil field water supply 9 Dewatering 12 Other (Specify below)
2 Irrigation 4 Industrial 7 Lawn and garden only 10 Monitoring well _____
 Was a chemical/bacteriological sample submitted to Department? Yes _____ No X; If yes, mo/day/yr sample was sub-
 mitted _____ Water Well Disinfected? Yes _____ No X

5 TYPE OF BLANK CASING USED: 5 Wrought iron 8 Concrete tile CASING JOINTS: Glued _____ Clamped X
 1 Steel 3 RMP (SR) 6 Asbestos-Cement 9 Other (specify below) Welded _____
 2 PVC 4 ABS 7 Fiberglass _____ Threaded _____
 Blank casing diameter 16 in. to 58 ft., Dia _____ in. to _____ ft., Dia _____ in. to _____ ft.
 Casing height above land surface 24 in., weight _____ lbs./ft. Wall thickness or gauge No. 50
 TYPE OF SCREEN OR PERFORATION MATERIAL: 7 PVC 10 Asbestos-cement
 1 Steel 3 Stainless steel 5 Fiberglass 8 RMP (SR) 11 Other (specify) _____
 2 Brass 4 Galvanized steel 6 Concrete tile 9 ABS 12 None used (open hole)
 SCREEN OR PERFORATION OPENINGS ARE: 5 Gauzed wrapped 8 Saw cut 11 None (open hole)
 1 Continuous slot 3 Mill slot 6 Wire wrapped 9 Drilled holes
 2 Louvered shutter 4 Key punched 7 Torch cut 10 Other (specify) _____
 SCREEN-PERFORATED INTERVALS: From 58 ft. to 78 ft., From _____ ft. to _____ ft.
 From _____ ft. to _____ ft., From _____ ft. to _____ ft.
 GRAVEL PACK INTERVALS: From 20 ft. to 70 ft., From _____ ft. to _____ ft.
 From _____ ft. to _____ ft., From _____ ft. to _____ ft.

6 GROUT MATERIAL: 1 Neat cement 2 Cement grout 3 Bentonite 4 Other _____
 Grout Intervals: From 0 ft. to 20 ft., From _____ ft. to _____ ft., From _____ ft. to _____ ft.
 What is the nearest source of possible contamination: 10 Livestock pens 14 Abandoned water well
 1 Septic tank 4 Lateral lines 7 Pit privy 11 Fuel storage 15 Oil well/Gas well
 2 Sewer lines 5 Cess pool 8 Sewage lagoon 12 Fertilizer storage 16 Other (specify below)
 3 Watertight sewer lines 6 Seepage pit 9 Feedyard 13 Insecticide storage _____
 Direction from well? S.W. How many feet? 30'

FROM	TO	LITHOLOGIC LOG	FROM	TO	PLUGGING INTERVALS
0	3	BLACK GUMBO			
3	4	OLD SLUSH PIT			
4	29	BLACK & BROWN CLAYS			
29	31	FINE BROWN SAND			
31	38	MEDIUM BROWN SAND			
38	50	SMALL-MEDIUM GREY GRAVEL & GREY CLAY			
50	52	FINE GREY SAND & GREY CLAY			
52	59	FINE GREY GRAVEL			
59	62	MEDIUM-LARGE GREY GRAVEL			
62	65	SMALL-MEDIUM GREY GRAVEL & GREY CLAY			
65	75	MEDIUM-LARGE GREY GRAVEL			
75	78	LARGE GREY GRAVEL & COBBLES			
	78	BOULDERS & SHALE , STOPPED			

7 CONTRACTOR'S OR LANDOWNER'S CERTIFICATION: This water well was (1) constructed, (2) reconstructed, or (3) plugged under my jurisdiction and was completed on (mo/day/year) 7-2-96 and this record is true to the best of my knowledge and belief. Kansas Water Well Contractor's License No. 323. This Water Well Record was completed on (mo/day/yr), 7-11-96 under the business name of HOUBLER DRILLING CO. by (signature) Daniel Hoobler