


1 LOCATION OF WATER WELL: Fraction NEAR center 1/4 Section Number 35 Township Number T 9 S Range Number R 10 **EWKX**  
 County: POTTAWATOMIE

Distance and direction from nearest town or city street address of well if located within city?  
FROM WAMEGO KS. 1/2 MILE EAST, 1/2 MILE NORTH, 1 MILE EAST, 3/4 MILE NORTH, & 1/2 MILE EAST

2 WATER WELL OWNER: EVERETT BOYCE  
 RR#, St. Address, Box # : 5355 LOUIS VIEUX ROAD Board of Agriculture, Division of Water Resources  
 City, State, ZIP Code : WAMEGO KS 66547 Application Number: 42539

3 LOCATE WELL'S LOCATION WITH AN "X" IN SECTION BOX:

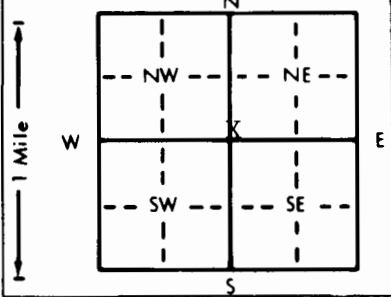

4 DEPTH OF COMPLETED WELL... 80 ft. ELEVATION: .....  
 Depth(s) Groundwater Encountered 1. 24 ft. 2. .... ft. 3. .... ft.  
 WELL'S STATIC WATER LEVEL ... 24 ft. below land surface measured on mo/day/yr .. 1-21-97.....  
 Pump test data: Well water was 35 ft. after 1 hours pumping ... 850 gpm  
 Est. Yield 1500 gpm: Well water was 38 ft. after 1 hours pumping .. 1000 gpm  
 Bore Hole Diameter... 32 in. to 80 ft., and ..... in. to ..... ft.  
 WELL WATER TO BE USED AS: 5 Public water supply 8 Air conditioning 11 Injection well  
 1 Domestic 3 Feedlot 6 Oil field water supply 9 Dewatering 12 Other (Specify below)  
 2 Irrigation 4 Industrial 7 Lawn and garden only 10 Monitoring well .....  
 Was a chemical/bacteriological sample submitted to Department? Yes.....No X.....; If yes, mo/day/yr sample was sub-  
 mitted Water Well Disinfected? Yes No X

5 TYPE OF BLANK CASING USED: 5 Wrought iron 8 Concrete tile CASING JOINTS: Glued X Clamped X  
 1 Steel 3 RMP (SR) 6 Asbestos-Cement 9 Other (specify below) Welded .....  
 2 PVC 4 ABS 7 Fiberglass Threaded.....

Blank casing diameter ... 16 in. to ..... ft., Dia ..... in. to ..... ft., Dia ..... in. to ..... ft.  
 Casing height above land surface... 12 in., weight ..... lbs./ft. Wall thickness or gauge No. ... 50

TYPE OF SCREEN OR PERFORATION MATERIAL: 7 PVC 10 Asbestos-cement  
 1 Steel 3 Stainless steel 5 Fiberglass 8 RMP (SR) 11 Other (specify) .....  
 2 Brass 4 Galvanized steel 6 Concrete tile 9 ABS 12 None used (open hole)

SCREEN OR PERFORATION OPENINGS ARE: 5 Gauzed wrapped 8 Saw cut 11 None (open hole)  
 1 Continuous slot 3 Mill slot 6 Wire wrapped 9 Drilled holes  
 2 Louvered shutter 4 Key punched 7 Torch cut 10 Other (specify) .....

SCREEN-PERFORATED INTERVALS: From... 40 ft. to 80 ft., From ..... ft. to ..... ft.  
 From ..... ft. to ..... ft., From ..... ft. to ..... ft.  
 GRAVEL PACK INTERVALS: From... 20 ft. to 80 ft., From ..... ft. to ..... ft.  
 From ..... ft. to ..... ft., From ..... ft. to ..... ft.

6 GROUT MATERIAL: 1 Neat cement 2 Cement grout 3 Bentonite 4 Other .....  
 Grout Intervals: From... 0 ft. to 20 ft., From ..... ft. to ..... ft., From ..... ft. to ..... ft.

What is the nearest source of possible contamination:  
 1 Septic tank 4 Lateral lines 7 Pit privy 10 Livestock pens 14 Abandoned water well  
 2 Sewer lines 5 Cess pool 8 Sewage lagoon 11 Fuel storage 15 Oil well/Gas well  
 3 Watertight sewer lines 6 Seepage pit 9 Feedyard 12 Fertilizer storage 16 Other (specify below)  
 13 Insecticide storage NONE.....

Direction from well? How many feet?

FROM	TO	LITHOLOGIC LOG	FROM	TO	PLUGGING INTERVALS
0	2	BLACK TOP SOIL			
2	18	BROWN & GREY CLAYS			
18	34	SOFT BROWN CLAY			
34	44	SMALL-MEDIUM GREY GRAVEL & GREY CLAY			
44	45	MEDIUM GREY GRAVEL			
45	48	FINE GREY SAND			
48	51	MEDIUM-LARGE GREY GRAVEL & GREY CLAY			
51	64	MEDIUM-LARGE GREY GRAVEL			
64	67	SMALL-MEDIUM GREEN GRAVEL			
67	75	MEDIUM-LARGE GREEN GRAVEL & COBBLES			
75	80	MEDIUM GREY GRAVEL			
	80	GREEN SHALE , STOPPED			

7 CONTRACTOR'S OR LANDOWNER'S CERTIFICATION: This water well was (1) constructed, (2) reconstructed, or (3) plugged under my jurisdiction and was completed on (mo/day/year) ... 1-21-97 ..... and this record is true to the best of my knowledge and belief. Kansas Water Well Contractor's License No. .... 323 ..... This Water Well Record was completed on (mo/day/yr) ... 1-27-97 ..... under the business name of HOUBLER DRILLING CO. by (signature) Dan Hoobler