

NW NW NW

30 - 9 - 10E

CORRECTION(S) TO WATER WELL RECORD (WWC-5)

(to rectify lacking or incorrect information)

County: POTTAWATOMIE

Location listed as:

Section-Township-Range: 31-9-10E

Fraction (1/4 1/4 1/4): NW NW NW

Location changed to:

30-9-10E

NW NW NW

Other changes: Initial statements: _____

Changed to: _____

Comments: _____

verification method: Landowner called well not on his property.

Belongs North of him. New Development (note contamination source on WWC5 says new construction) by M. Ebert is one mile ^{North} sec. 30 initials: DA date: 1-31-2012

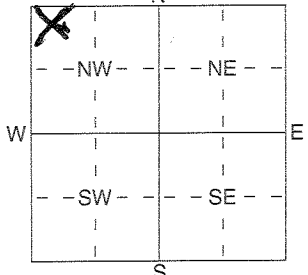
submitted by: Kansas Geological Survey, Data Resources Library, 1930 Constant Ave., Lawrence, KS 66047-3726

to: Kansas Dept of Health & Environment, Bureau of Water, 1000 SW Jackson, Suite 420, Topeka, KS 66612-1367.

1 LOCATION OF WATER WELL: Fraction NW 1/4 NW 1/4 NW 1/4 Section Number 31 Township Number T 9 S Range Number R 10 E


2 WATER WELL OWNER: Mark Ebert
 RR#, St. Address, Box # : 6240 SALZRR RD Board of Agriculture, Division of Water Resources
 City, State, ZIP Code : Warrner, Mo. US. 64654 Application Number:

3 LOCATE WELL'S LOCATION WITH AN "X" IN SECTION BOX:

 4 DEPTH OF COMPLETED WELL 120 ft. ELEVATION:
 Depth(s) Groundwater Encountered: 1 42 ft. 2 64 ft. 3 _____ ft.
 WELL'S STATIC WATER LEVEL 42 ft. below land surface measured on mo/day/yr 12/9/02
 Pump test data: Well water was _____ ft. after _____ hours pumping _____ gpm
 Est. Yield 3 gpm: Well water was _____ ft. after _____ hours pumping _____ gpm
 WELL WATER TO BE USED AS: 1 Domestic 3 Feedlot 6 Oil field water supply 9 Dewatering 12 Other (Specify below)
 2 Irrigation 4 Industrial 7 Domestic (lawn & garden) 10 Monitoring well
 Was a chemical/bacteriological sample submitted to Department? Yes _____ No X; If yes, mo/day/yr sample was submitted
 Water Well Disinfected? Yes X No

5 TYPE OF BLANK CASING USED:
 1 Steel 3 RMP (SR) 5 Wrought iron 8 Concrete tile CASING JOINTS: Glued Clamped _____
2 PVC 4 ABS 6 Asbestos-Cement 9 Other (specify below) Welded _____
 7 Fiberglass Threaded _____
 Blank casing diameter 5 in. to 40 ft. Dia 5 in. to 110 ft. Dia _____ in. to _____ ft.
 Casing height above land surface 18 in., weight _____ lbs./ft. Wall thickness or gauge No. SDR 26
 TYPE OF SCREEN OR PERFORATION MATERIAL:
 1 Steel 3 Stainless Steel 5 Fiberglass 6 PVC 10 Asbestos-Cement
 2 Brass 4 Galvanized Steel 6 Concrete tile 8 RMP (SR) 11 Other (Specify) _____
 9 ABS 12 None used (open hole)
 SCREEN OR PERFORATION OPENINGS ARE:
 1 Continuous slot 3 Mill slot 40 5 Gauzed wrapped 8 Saw cut 11 None (open hole)
 2 Louvered shutter 4 Key punched 6 Wire wrapped 9 Drilled holes 10 Other (specify) _____ ft.
 7 Torch cut
 SCREEN-PERFORATED INTERVALS: From 20 ft. to 110 ft. From 50 ft. to 40 ft.
 From _____ ft. to _____ ft. From _____ ft. to _____ ft.
 GRAVEL PACK INTERVALS: From 25 ft. to 120 ft. From _____ ft. to _____ ft.
 From _____ ft. to _____ ft. From _____ ft. to _____ ft.

6 GROUT MATERIAL: 1 Neat cement 2 Cement grout 3 Bentonite 4 Other _____
 Grout intervals: From 25 ft. to 0 ft., From _____ ft. to _____ ft., From _____ ft. to _____ ft.
 What is the nearest source of possible contamination:
 1 Septic tank 4 Lateral lines 7 Pit privy 11 Fuel storage 14 Abandoned water well
 2 Sewer lines 5 Cess pool 8 Sewage lagoon 12 Fertilizer storage 15 Oil well/Gas well
 3 Watertight sewer lines 6 Seepage pit 9 Feedyard 13 Insecticide storage 16 Other (specify below)
NEW CONSTRUCTION
 Direction from well? _____ How many feet? _____

FROM	TO	LITHOLOGIC LOG	FROM	TO	PLUGGING INTERVALS
0	18	CLAY			
18	25	SAND, PINK			
25	30	SANDY CLAY			
30	35	SAND			
35	40	CLAY			
40	64	SHALE			
64	77	SANDSTONE			
77	80	SANDSTONE			
80	120	SHALE			
	120	TD			

7 CONTRACTOR'S OR LANDOWNER'S CERTIFICATION: This water well was (1) constructed, (2) reconstructed, or (3) plugged under my jurisdiction and was completed on (mo/day/yr) 12/9/02 and this record is true to the best of my knowledge and belief. Kansas Water Well Contractor's Licence No 505 This Water Well Record was completed on (mo/day/yr) 1/10/03 under the business name of ASSOCIATED DEVELOPMENT INC. by (signature) [Signature]