


1 LOCATION OF WATER WELL: Fraction **NE 1/4 SE 1/4 SW 1/4** Section Number **32** Township Number **T 9 S** Range Number **R 10 @ W/W**
 County: **Pottawatomie**

Distance and direction from nearest town or city street address of well if located within city?
Approximately 1/4 mile north of Columbian and Say road intersection.

2 WATER WELL OWNER: **US Army Corps of Engineers - AHW: Saqik Khan**
 Board of Agriculture, Division of Water Resources
 Application Number: **>**
 FR#, St. Address, Box #: **501 East 12th St. Rm 610**
 City, State, ZIP Code: **Kansas City, Mo. 64106**

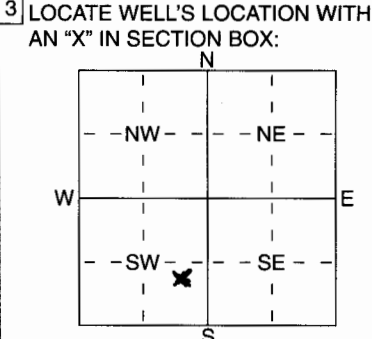

4 DEPTH OF COMPLETED WELL **105.5'** ELEVATION: **1107.99'** *amsl - ground surface*
 Depth(s) Groundwater Encountered **96.73 96.97** ft. 2 ft. 3 ft.
 WELL'S STATIC WATER LEVEL: **96.73** ft. below land surface measured on mo/day/yr **6/30/04**
 Pump test data: Well water was ft. after hours pumping gpm
 Est. Yield gpm: Well water was ft. after hours pumping gpm
 WELL WATER TO BE USED AS:
 1 Domestic 3 Feedlot 6 Oil field water supply 9 Dewatering 12 Other (Specify below)
 2 Irrigation 4 Industrial 7 Domestic (lawn & garden) **10 Monitoring well**
 Was a chemical/bacteriological sample submitted to Department? Yes No ; If yes, mo/day/yr sample was submitted
 Water Well Disinfected? Yes No

5 TYPE OF BLANK CASING USED:
 1 Steel 3 RMP (SR) 5 Wrought iron 8 Concrete tile CASING JOINTS: Glued Clamped
 2 PVC 4 ABS 7 Fiberglass 9 Other (specify below) Welded
 Blank casing diameter **2"** in. to ft., Dia in. to ft., Dia in. to ft.
 Casing height above land surface **1.54'** in., weight lbs./ft. Wall thickness or gauge No.
 TYPE OF SCREEN OR PERFORATION MATERIAL:
 1 Steel 3 Stainless Steel 5 Fiberglass 8 RMP (SR) 10 Asbestos-Cement
 2 Brass 4 Galvanized Steel 6 Concrete tile 9 ABS 11 Other (Specify)
 12 None used (open hole)
 SCREEN OR PERFORATION OPENINGS ARE:
 1 Continuous slot 3 Mill slot 5 Gauzed wrapped 8 Saw cut 11 None (open hole)
 2 Louvered shutter 4 Key punched 6 Wire wrapped 9 Drilled holes 10 Other (specify) ft.
 SCREEN-PERFORATED INTERVALS: From **95.0'** ft. to **105.5'** ft., From ft. to ft.
 GRAVEL PACK INTERVALS: From **91.4'** ft. to **109.0'** ft., From ft. to ft.

6 GROUT MATERIAL: 1 Neat cement 2 Cement grout 3 Bentonite Seal 4 Other
 Grout Intervals: From **3.0'** ft. to **87.6'** ft., From **87.6'** ft. to **91.4'** ft., From ft. to ft.
 What is the nearest source of possible contamination:
 1 Septic tank 4 Lateral lines 7 Pit privy 10 Livestock pens 14 Abandoned water well
 2 Sewer lines 5 Cess pool 8 Sewage lagoon 11 Fuel storage 15 Oil well/Gas well
 3 Watertight sewer lines 6 Seepage pit 9 Feedyard 12 Fertilizer storage 16 Other (specify below)
 Direction from well? **Former Ford's S-7 Atlas Missile Site**
 How many feet? **7**

FROM	TO	LITHOLOGIC LOG	FROM	TO	PLUGGING INTERVALS
0	4.0	Topsoil / Fill			
4.0	11.8	Clayey clay - reddish brown			
11.8	34.8	Sand - coarse orange-brown			
34.8	70.5	Silt, Tan, dense			
70.5	83.2	Silt, Tan, sand and clay lenses, perched zones			
83.2	105.5	SAND - Medium to fine with coarse zones, saturated below 97.0' bgs.			
105.5	108.0	Siltstone - dry, poorly cemented			
108.0	109.0	Shale - weathered	(Both)		

RECEIVED
 AUG 26 2004
 BUREAU OF WATER

7 CONTRACTOR'S OR LANDOWNER'S CERTIFICATION: This water well was (1) constructed, (2) reconstructed, or (3) plugged under my jurisdiction and was completed on (mo/day/year) **6/29/04** and this record is true to the best of my knowledge and belief. Kansas Water Well Contractor's Licence No. **Federal Government** This Water Well Record was completed on (mo/day/yr) **6/23/04** under the business name of **US Army Corps of Engineers** by (signature) **Raymond Geologies**