


1	LOCATION OF WATER WELL:	Fraction	Section Number	Township Number	Range Number
County:	<u>Pottawatomie</u>	<u>SW 1/4 SW 1/4 SE 1/4</u>	<u>30</u>	<u>9S</u>	<u>10E</u>

Distance and direction from nearest town or city street address of well if located within city?
1/2 N of Wamego

2 WATER WELL OWNER: Cape

RR #, St. Address, Box #: _____
 City, State, ZIP Code : _____

Board of Agriculture, Division of Water Resources
 Application Number: _____

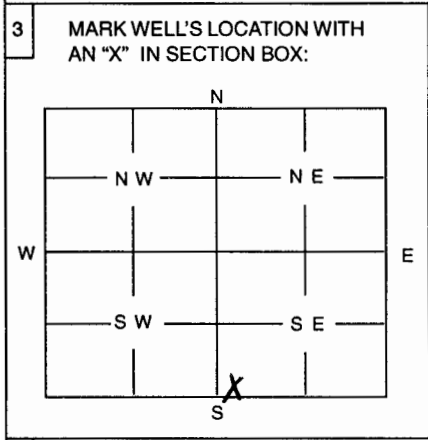

4 DEPTH OF WELL 80 ft

WELL'S STATIC WATER LEVEL 54 ft.

WELL WAS USED AS:

1 Domestic	5 Public Water Supply	9 Dewatering
2 Irrigation	6 Oil Field Water Supply	10 Monitoring Well
3 Feedlot	7 Domestic (Lawn & Garden)	11 Injection Well
4 Industrial	8 Air Conditioning	12 Other <u>T.H. # 7</u>

Was a chemical / bacteriological sample submitted to Department? Yes No _____
 If yes, mo/day/yr sample was submitted

Water Well Disinfected: Yes X No

5 TYPE OF BLANK CASING USED:

1 Steel	3 RMP (SR)	5 Wrought	7 Fiberglass	9 Other (Specify below)
<u>2 PVC</u>	4 ABS	6 Asbestos-Cement	8 Concrete Tile	

Blank casing diameter... 2 in. Was casing pulled? Yes No X If yes, how much

Casing height above or below land surface Below 36 in. cut off 3' below ground

6 GROUT PLUG MATERIAL: 1 Neat cement 2 Cement grout 3 Bentonite 4 Other

Grout Plug Intervals: From 3 ft. to 80 ft., From ft. to ft., From to ft.

What is the nearest source of possible contamination:

1 Septic tank	6 Seepage pit	11 Fuel storage	<u>16</u> Other (specify below)
2 Sewer lines	7 Pit privy	12 Fertilizer storage	<u>ditch</u>
3 Watertight sewer lines	8 Sewage lagoon	13 Insecticide storage	
4 Lateral lines	9 Feedyard	14 Abandoned water well	
5 Cess Pool	10 Livestock pens	15 Oil well/Gas well	

Direction from well? S How many feet? 75

FROM	TO	PLUGGING MATERIALS
<u>3</u>	<u>80</u>	<u>Bentonite</u>

7 CONTRACTOR'S OR LANDOWNER'S CERTIFICATION: This water well was plugged under my jurisdiction and was completed on (mo/day/year) 1-4-2007 and this record is true to the best of my knowledge and belief. Kansas Water Well Contractor's License No. 182 This Water Well Record was completed on (mo/day/year) 6-5-2007 under the business name of Strader Drilling Co. Inc by (signature) [Signature]

INSTRUCTIONS: Use typewriter or ball point pen. Please press firmly and print clearly. Please fill in blanks, underline or circle the correct answers. Send top three copies to Kansas Department of Health and Environment, Bureau of Water, Topeka, Kansas 66620-0001. Telephone: 785/296-3565. Send one to Water Well Owner and retain one for your records.