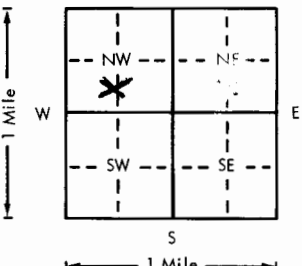
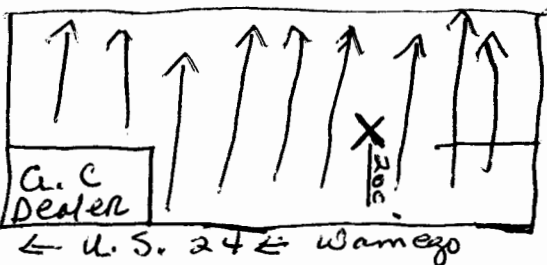


USE TYPEWRITER OR BALL POINT PEN-PRESS FIRMLY, PRINT CLEARLY.

WATER WELL RECORD
KSA 82a-1201-1215

Kansas Department of Health and Environment-Division of Environment
(Water well Contractors)
Topeka, Kansas 66620

<input checked="" type="checkbox"/> Location of well:	County Pottawatomie	Fraction Ctr. 1/4 of S1/4 - SW 1/4 ^{MW}	Section number 3	Township number T 9 S R 10 E/W	Range number 10
2. Distance and direction from nearest town or city: Wamego, Ks. on U.S. 24. 1/2 mi. East of			3. Owner of well: Jim Meinhardt		
Street address of well location if in city:			R.R. or street: Highway 24 East		
			City, state, zip code: Wamego, Kansas 66547		
4. Locate with "X" in section below:			Sketch map: N		
					
6. Bore hole dia. 30 in. Completion date 5-3-77			Well depth 83 ft.		
7. <input type="checkbox"/> Cable tool <input type="checkbox"/> Rotary <input type="checkbox"/> Driven <input type="checkbox"/> Dug			<input type="checkbox"/> Hollow rod <input type="checkbox"/> Jetted <input type="checkbox"/> Bored <input checked="" type="checkbox"/> Reverse rotary		
8. Use: <input type="checkbox"/> Domestic <input type="checkbox"/> Public supply <input type="checkbox"/> Industry			<input checked="" type="checkbox"/> Irrigation <input type="checkbox"/> Air conditioning <input type="checkbox"/> Stock		
			<input type="checkbox"/> Lawn <input type="checkbox"/> Oil field water <input type="checkbox"/> Other		
9. Casing: Material Transite Weight: Above or below			Threaded <input type="checkbox"/> Welded <input type="checkbox"/> Surface 12 in.		
RMP <input type="checkbox"/> PVC <input type="checkbox"/> Weight <input type="checkbox"/> lbs./ft.			Dia. 16 in. to 44 ft. depth, Wall Thickness: inches or		
Dia. <input type="checkbox"/> in. to <input type="checkbox"/> ft. depth			Gage No. .75"		
10. Screen: Manufacturer's name Johnson Well Casing Co.			Type Transite Dia. 16"		
Slot/gauze 1/8 x 8 Length 39'			Set between 44 ft. and 83 ft.		
			Gravel pack? yes Size range of material 1/8-1/4		
11. Static water level: <input type="checkbox"/> mo./day/yr.			31 ft. below land surface Date 5-3-77		
12. Pumping level below land surfaces:			41 ft. after 1 hrs. pumping 800 g.p.m.		
			53 ft. after 3 hrs. pumping 1200 g.p.m.		
Estimated maximum yield 1500 g.p.m.			13. Water sample submitted: <input type="checkbox"/> mo./day/yr.		
			<input type="checkbox"/> Yes <input checked="" type="checkbox"/> No Date 5-3-77		
14. Well head completion:			<input type="checkbox"/> Pitless adapter <input type="checkbox"/> Inches above grade		
15. Well grouted? yes			With: <input type="checkbox"/> Neat cement <input type="checkbox"/> Bentonite <input checked="" type="checkbox"/> Concrete		
Depth: From 0 ft. to 10 ft.			16. Nearest source of possible contamination: house		
			ft. 400 Direction south Type laterals		
Well disinfected upon completion? <input type="checkbox"/> Yes <input checked="" type="checkbox"/> No			17. Pump: <input checked="" type="checkbox"/> Not installed		
18. Elevation:			Manufacturer's name Hoobler Drilling Co. 323		
19. Remarks:			Business name St. Marys, Ks. 66536 License No.		
We do not install pumps. Leveled for flood irrigation.			Address St. Marys, Ks. 66536		
			Signed Don Halbur Date 5-23-77		
Topography: <input type="checkbox"/> Hill <input type="checkbox"/> Slope <input checked="" type="checkbox"/> Upland <input type="checkbox"/> Valley			Authorized representative		

T-2
 R-100
 W-3
 Sec-0
 1/4 NW
 1/4 NW