USE TYPEWRITER OR BALL POINT PEN-PRESS FIRMLY, PRINT CLEARLY.

WATER WELL RECORD
KSA 82a-1201-1215

Kansas Department of Health and Environment-Division of Environment
(Water well Contractors)
Topeka, Kansas 66620

1. Location of well:	County	Fraction	Section number	Township number	Range number
	Pottawatomie	Ctr of N½ ~~xx~~ NW 1/4	3	T 9 S	R 10 E/W

2. Distance and direction from nearest town or city street address of well location if in city: ½ mi. East of Wamego, Ks. on U.S.24 & ~~3/4~~ ½ + 1/4 mi. North

3. Owner of well: Louis Weixelman
R.R. or street: R. R. #1
City, state, zip code: Wamego, Kansas 66547

4. Locate with "X" in section below:

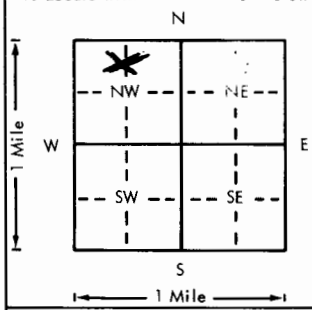

Sketch map:

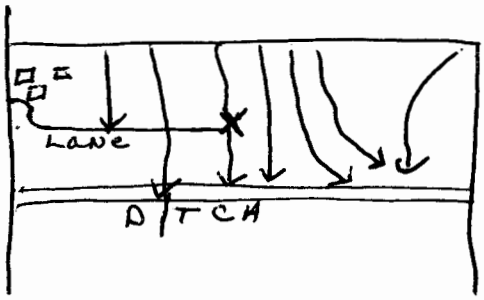

5. Type and color of material	From	To
Black gumbo	0	5
Brown silty clay	5	41
Fine gray sand	41	42
Med. to large grey gravel	42	49
Small to med. grey gravel	49	50
Med. to large gray gravel	50	55
Med. to large gray gravel	55	60
Small to med. gray gravel	60	65
Med. to large gray gravel	65	70
Large gray gravel	70	75
Large gray gravel	75	80
Large green gravel-stopped.	80	82

(Use a second sheet if needed)

6. Bore hole dia. 30 in. Completion date 5-4-77
Well depth 82 ft.

7. __ Cable tool __ Rotary __ Driven __ Dug
__ Hollow rod __ Jetted __ Bored X Reverse rotary

8. Use: __ Domestic __ Public supply __ Industry
X Irrigation __ Air conditioning __ Stock
__ Lawn __ Oil field water __ Other

9. Casing: Material Trans. Height: Above or below
Threaded ___ Welded ___ Surface 12 in.
RMP ___ PVC ___ Weight ___ lbs./ft.
Dia. 16 in. to 44 ft. depth Wall Thickness: inches or
Dia. ___ in. to ___ ft. depth gage No. .75"

10. Screen: Manufacturer's name Johnson Well Casing Co.
Type Transite Dia. 16"
Slot/gauze 1/8 x 8 Length 39'
Set between ~~44~~ 43 ft. and 82 ft.
___ ft. and ___ ft.
Gravel pack? yes Size range of material 1/8-1/4

11. Static water level: mo./day/yr.
32 ft. below land surface Date 5-4-77

12. Pumping level below land surfaces:
45 ft. after 1 hrs. pumping 800 g.p.m.
59 ft. after 3 hrs. pumping 1200 g.p.m.
Estimated maximum yield 1500 g.p.m.

13. Water sample submitted: mo./day/yr.
__ Yes X No Date ___

14. Well head completion:
__ Pitless adapter ___ Inches above grade

15. Well grouted? yes
With: __ Neat cement __ Bentonite X Concrete
Depth: From 0 ft. to 10 ft.

16. Nearest source of possible contamination abandoned
ft. 1200 Direction west Type farmstead
Well disinfected upon completion? ___ Yes X No

17. Pump: X Not installed
Manufacturer's name ___
Model number ___ HP ___ Volts ___
Length of drop pipe ___ ft. capacity ___ g.p.m.
Type:
__ Submersible __ Turbine
__ Jet __ Reciprocating
__ Centrifugal __ Other

T 9 R 10 W Sec 3 1/4 1/4 1/4 1/4

18. Elevation:

Topography:
__ Hill
__ Slope
X Upland
__ Valley

19. Remarks:
We do not install pumps.

20. Water well contractor's certification:
This well was drilled under my jurisdiction and this report is true to the best of my knowledge and belief.
Hoobler Drilling Co. 323
Business name License No.
Address St. Marys, Ks. 66536
Signed Don Hoobler Date 5-23-77
Authorized representative

Forward the white, blue and pink copies to the Department of Health and Environment

Form WWC-5