


USE TYPEWRITER OR BALL POINT PEN-PRESS FIRMLY, PRINT CLEARLY.

WATER WELL RECORD
KSA 82a-1201-1215

Kansas Department of Health and Environment-Division of Environment
(Water well Contractors)
Topeka, Kansas 66620

1. Location of well: County Pottawatomie Fraction N.W. 1/4 of NW 1/4 Section number 9 Township number T. 9 S Range number R. 10 E E/W

2. Distance and direction from nearest town or city: Louisville 3 M. N. on east side road
3. Owner of well: Pottawatomie Co.
Street address of well location if in city: at Co. trash Burial site R.R. or street:
City, state, zip code: Westmorland Kans 66549

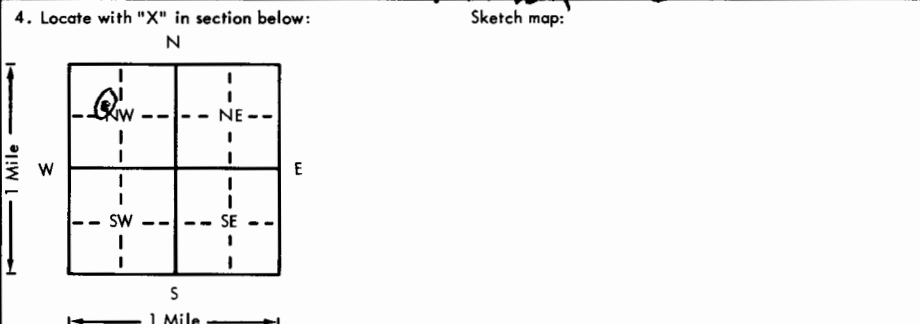

6. Bore hole dia. 10 in. Completion date 5-1-76
Well depth 73 ft.
7. Cable tool Rotary Driven Dug
 Hollow rod Jetted Bored Reverse rotary
8. Use: Domestic Public supply Industry monitoring well
 Irrigation Air conditioning Stock
 Lawn Oil field water Other
9. Casing: Material PVC Height: Above or below
Threaded Welded Surface 38 in.
RMP PVC Weight 3.40 lbs./ft.
Dia. 4 in. to 73 ft. depth Wall Thickness: inches or
Dia. 4 in. to 73 ft. depth No.

5. Type and color of material

	From	To
<u>Top Soil</u>	<u>1</u>	<u>3'</u>
<u>Yellow Clay</u>	<u>3'</u>	<u>8</u>
<u>Loose rock on top of Limestone ledge</u>	<u>8</u>	<u>22</u>
<u>Blue shale</u>	<u>22</u>	<u>40</u>
<u>Blue Limestone</u>	<u>40</u>	<u>50</u>
<u>Blue Shale</u>	<u>50</u>	<u>73</u>

10. Screen: Manufacturer's name Pumpco
Type PVC Dia. 4"
Slot size 0.30 Length 10ft + 30ft
Set between 16 ft. and 26 ft.
Dia. 53 ft. and 73 ft.
Gravel pack? Size range of material 4X8
11. Static water level: 20 ft. below land surface Date 5-1-76 mo./day/yr.
12. Pumping level below land surfaces:
____ ft. after ____ hrs. pumping ____ g.p.m.
____ ft. after ____ hrs. pumping ____ g.p.m.
Estimated maximum yield 10 g.p.m.
13. Water sample submitted: ____ mo./day/yr.
 Yes No Date ____
14. Well head completion: NA
 Pitless adapter ____ Inches above grade
15. Well grouted?
With: Neat cement Bentonite Concrete
Depth: From 16 ft. to 0 ft.
16. Nearest source of possible contamination: 100 ft. Direction east Type Creek
Well disinfected upon completion? Yes No
17. Pump: Not installed
Manufacturer's name ____
Model number ____ HP ____ Volts ____
Length of drop pipe ____ ft. capacity ____ g.p.m.
Type:
 Submersible Turbine
 Jet Reciprocating
 Centrifugal Other

18. Elevation: Topography: Hill Slope Upland Valley
19. Remarks: (Use a second sheet if needed)

20. Water well contractor's certification:
This well was drilled under my jurisdiction and this report is true to the best of my knowledge and belief.
Strader Drilling Co 237
Business name Harold Strader License No. ____
Address Harold Strader
Signed Harold Strader Date 5-1-76
Authorized representative

66549
76
monitoring well
9-10E
9
NW 1/4
NW 1/4