


1 LOCATION OF WATER WELL: County: POTT Fraction: SW 1/4 SE 1/4 NW 1/4 Section Number: 12 Township Number: T 9 S Range Number: R 10 E/W

Distance and direction from nearest town or city street address of well if located within city? From Louisville Go North East 5 Miles on County Road to Township Road + Go East 1/4 Mile

2 WATER WELL OWNER: Alice J. Fairchild
 RR#, St. Address, Box #: RR#3 Box 7
 City, State, ZIP Code: Louisville, KS 66450
 Board of Agriculture, Division of Water Resources
 Application Number:

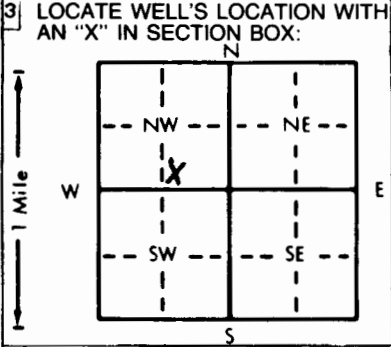

4 DEPTH OF COMPLETED WELL: 100' ft. ELEVATION: ft.
 Depth(s) Groundwater Encountered 1. 30' ft. 2. ft. 3. ft.
 WELL'S STATIC WATER LEVEL: 2.6 ft. below land surface measured on mo/day/yr ft.
 Pump test data: Well water was ft. after hours pumping gpm
 Est. Yield: 2 gpm: Well water was ft. after hours pumping gpm
 Bore Hole Diameter: 9 in. to 100' ft., and in. to ft.
 WELL WATER TO BE USED AS:
 1 Domestic 3 Feedlot 6 Oil field water supply 9 Dewatering 12 Other (Specify below)
 2 Irrigation 4 Industrial 7 Lawn and garden only 10 Monitoring well
 Was a chemical/bacteriological sample submitted to Department? Yes.....No.....; If yes, mo/day/yr sample was submitted
 Water Well Disinfected? Yes No

5 TYPE OF BLANK CASING USED:
 1 Steel 3 RMP (SR) 6 Asbestos-Cement 9 Other (specify below)
 2 PVC 4 ABS 7 Fiberglass 8 Concrete tile 10 Asbestos-cement
 Blank casing diameter: 5 in. to 80 ft., Dia in. to ft., Dia in. to ft.
 Casing height above land surface: 2' in., weight 504.40 lbs./ft. Wall thickness or gauge No.

TYPE OF SCREEN OR PERFORATION MATERIAL:
 1 Steel 3 Stainless steel 5 Fiberglass 7 PVC 10 Asbestos-cement
 2 Brass 4 Galvanized steel 6 Concrete tile 8 RMP (SR) 11 Other (specify)
 12 None used (open hole)

SCREEN OR PERFORATION OPENINGS ARE:
 1 Continuous slot 3 Mill slot 25/100's 5 Gauzed wrapped 8 Saw cut 11 None (open hole)
 2 Louvered shutter 4 Key punched 6 Wire wrapped 9 Drilled holes
 7 Torch cut 10 Other (specify)

SCREEN-PERFORATED INTERVALS: From 80 ft. to 100 ft., From ft. to ft.
 From ft. to ft., From ft. to ft.
 GRAVEL PACK INTERVALS: From 25 ft. to 100 ft., From ft. to ft.
 From ft. to ft., From ft. to ft.

6 GROUT MATERIAL: 1 Neat cement 2 Cement grout 3 Bentonite 4 Other
 Grout intervals: From 0 ft. to 25 ft., From ft. to ft., From ft. to ft.

What is the nearest source of possible contamination:
 1 Septic tank 4 Lateral lines 7 Pit privy 10 Livestock pens 14 Abandoned water well
 2 Sewer lines 5 Cess pool 8 Sewage lagoon 11 Fuel storage 15 Oil well/Gas well
 3 Watertight sewer lines 6 Seepage pit 9 Feedyard 12 Fertilizer storage 16 Other (specify below)
 13 Insecticide storage
 Direction from well? 80' North How many feet? 80'

FROM	TO	LITHOLOGIC LOG	FROM	TO	PLUGGING INTERVALS
0	2	Top Soil			
2	15	Brown Clay			
15	30	Greenish Shale			
30	36	Limestone (Water)			
36	44	Grey Shale			
44	47	Limestone			
47	87	Grey Shale			
87	93	Limestone			
93	100	Grey Shale			

7 CONTRACTOR'S OR LANDOWNER'S CERTIFICATION: This water well was (1) constructed, (2) reconstructed, or (3) plugged under my jurisdiction and was completed on (mo/day/year) 12/18/91 and this record is true to the best of my knowledge and belief. Kansas Water Well Contractor's License No. 451 This Water Well Record was completed on (mo/day/yr) 12/18/91 under the business name of Halderman Well Drilling by (signature) [Signature]