


USE TYPEWRITER OR BALL POINT PEN-PRESS FIRMLY, PRINT CLEARLY.

WATER WELL RECORD
KSA 82a-1201-1215

Kansas Department of Health and Environment-Division of Environment (Water well Contractors) Topeka, Kansas 66620

1. Location of well: County PEWABAWA TOPIA Fraction NE 1/4 NE 1/4 NE 1/4 Section number 20 Township number T 9 S R 10 EW

2. Distance and direction from nearest town or city: IN Louisville Street address of well location if in city: _____
3. Owner of well: LNU BRAYTON R.R. or street: RT 1 City, state, zip code: LOUISVILLE, KS. 66450

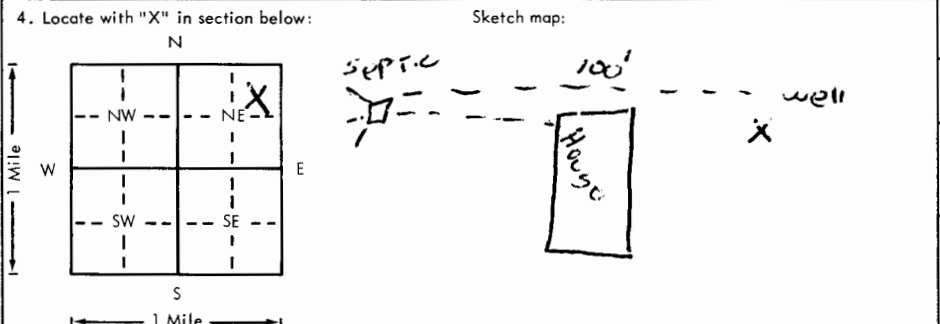

6. Bore hole dia. 10 in. Completion date _____ Well depth 50 ft. 7-3-78
7. Cable tool Rotary Driven Dug Hollow rod Jetted Bored Reverse rotary
8. Use: Domestic Public supply Industry Irrigation Air conditioning Stock Lawn Oil field water Other
9. Casing: Material PVC Height: Above or below Threaded _____ Welded _____ Surface 24 in. RMP _____ PVC 96 Weight 2.58 lbs./ft. Dia. 5 in. to 52 ft. depth Wall Thickness: inches or Dia. _____ in. to _____ ft. depth gage No. 1274

5. Type and color of material	From	To
<u>TOP SOIL</u>	<u>0</u>	<u>5</u>
<u>Clay, Brown silty</u>	<u>5</u>	<u>40</u>
<u>Fine sand - coarse sand GRAVEL</u>	<u>40</u>	<u>43</u>
<u>Shale, grey</u>	<u>43</u>	<u>50</u>

10. Screen: Manufacturer's name PUMPER MFG Type PVC Dia. 5 Sig/gauze 10/20 Length 20 Set between 30 ft. and 50 ft. Gravel pack? Size range of material 0.30x1.60
11. Static water level: _____ mo./day/yr. 18 ft. below land surface Date 7-3-78
12. Pumping level below land surfaces: _____ ft. after _____ hrs. pumping _____ g.p.m. Estimated maximum yield 6 g.p.m.
13. Water sample submitted: _____ mo./day/yr. Yes No Date _____
14. Well head completion: CAP Pitless adapter 24 inches above grade
15. Well grouted? With: Neat cement Bentonite Concrete Depth: From 0 ft. to 10 ft.
16. Nearest source of possible contamination: _____ ft. 100 Direction W Type SEPTIC Well disinfected upon completion? Yes No
17. Pump: Not installed Manufacturer's name _____ Model number _____ HP _____ Volts _____ Length of drop pipe _____ ft. capacity _____ g.p.m. Type: Submersible Turbine Jet Reciprocating Centrifugal Other

18. Elevation: _____ Topography: Hill Slope Upland Valley
19. Remarks: OWNER TO INSTALL SLAB
20. Water well contractor's certification: This well was drilled under my jurisdiction and this report is true to the best of my knowledge and belief. STRADER DALG CO 182 Business name License No. Address RT 1 HOLTOWN, KS Signed Dale Adams Date 7-5-78 Authorized representative

9
 100
 20
 NE NE NE
 1/4 1/4 1/4