


USE TYPEWRITER OR BALL POINT PEN-PRESS FIRMLY, PRINT CLEARLY.

WATER WELL RECORD  
KSA 82a-1201-1215

Kansas Department of Health and Environment-Division of Environment  
(Water well Contractors)  
Topeka, Kansas 66620

1. Location of well: County Pott Fraction SW 1/4 SW 1/4 SE 1/4 Section number 21 Township number T 9 S R 10 E/W Range number

2. Distance and direction from nearest town or city: 3-1/2 mi. of Wamego  
Street address of well location if in city:  
3. Owner of well: Roger Weeks  
R.R. or street:  
City, state, zip code: Louisville, Kans. 66450

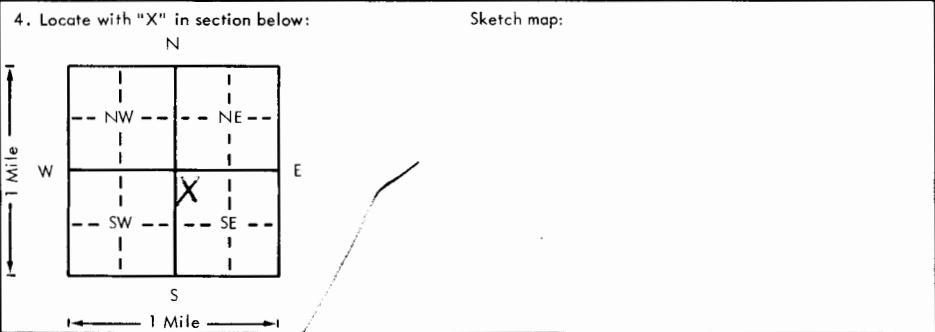

6. Bore hole dia. 8 in. Completion date Aug 4-80  
Well depth 55 ft.  
7.  Cable tool  Rotary  Driven  Dug  
 Hollow rod  Jetted  Bored  Reverse rotary  
8. Use:  Domestic  Public supply  Industry  
 Irrigation  Air conditioning  Stock  
 Lawn  Oil field water  Other  
9. Casing: Material PVC Height: Above or below  
Threaded  Welded Blue Surface 16 in.  
RMP  PVC  Weight  lbs./ft.  
Dia. 5 in. to 55 ft. depth Wall Thickness: inches or  
Dia.  in. to  ft. depth gage No. Sch 40

5. Type and color of material	From	To
clay Brown	0	10
" Black	24	40
Gravel Coars	40	45
Sand fine	45	50
Shale Blue	50	55
(Use a second sheet if needed)		

10. Screen: Manufacturer's name PUMPCO  
Type PVC Dia. 5"  
Slot/gauze 1/8 Length 20'  
Set between 35 ft. and 55 ft.  
Gravel pack? yes Size range of material 1/8-1/2  
11. Static water level: 25 ft. below land surface Date 8-4-80 mo./day/yr.  
12. Pumping level below land surfaces:  
\_\_\_\_ ft. after \_\_\_\_ hrs. pumping \_\_\_\_ g.p.m.  
\_\_\_\_ ft. after \_\_\_\_ hrs. pumping \_\_\_\_ g.p.m.  
Estimated maximum yield \_\_\_\_ g.p.m.  
13. Water sample submitted: \_\_\_\_ mo./day/yr.  
 Yes  No Date \_\_\_\_  
14. Well head completion:  
\_\_\_\_ Pitless adapter \_\_\_\_ inches above grade  
15. Well grouted? yes  
With:  Neat cement  Bentonite  Concrete  
Depth: From 4 ft. to 14 ft.  
16. Nearest source of possible contamination:  
ft. 100 Direction S Type Creek  
Well disinfected upon completion?  Yes  No  
17. Pump:  Not installed  
Manufacturer's name \_\_\_\_  
Model number \_\_\_\_ HP \_\_\_\_ Volts \_\_\_\_  
Length of drop pipe \_\_\_\_ ft. capacity \_\_\_\_ g.p.m.  
Type:  
 Submersible  Turbine  
 Jet  Reciprocating  
 Centrifugal  Other

18. Elevation: Topography:  Hill  Slope  Upland  Valley  
19. Remarks:  
20. Water well contractor's certification:  
This well was drilled under my jurisdiction and this report is true to the best of my knowledge and belief.  
Business name Harper Drilling Serv. 176 License No. Blue Rapids  
Address C. E. Harper  
Signed C. E. Harper Date 8-4-80  
Authorized representative

T 9-100 W 21 Sec 21 NW 1/4 1/4 1/4