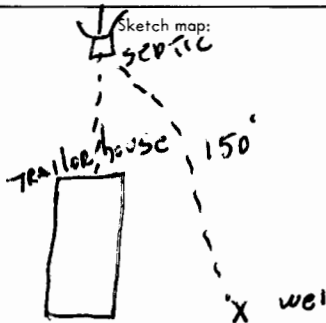


USE TYPEWRITER OR BALL POINT PEN-PRESS FIRMLY, PRINT CLEARLY.

WATER WELL RECORD
KSA 82a-1201-1215

Kansas Department of Health and Environment-Division of Environment
(Water well Contractors)
Topeka, Kansas 66620

1. Location of well:		County POTAWATOMIE	Fraction SW 1/4 SW 1/4 SW 1/4	Section number 21	Township number T 9 S R 10 E W	Range number												
2. Distance and direction from nearest town or city: IN Louisville			3. Owner of well: Tom Picolet R.R. or street: RR Louisville, KS 66450 City, state, zip code: 66450															
4. Locate with "X" in section below:			Sketch map: 		6. Bore hole dia. 12 in. Completion date _____ Well depth 55 ft. 10-4-78													
5. Type and color of material			7. Cable tool <input checked="" type="checkbox"/> Rotary <input type="checkbox"/> Driven <input type="checkbox"/> Dug <input type="checkbox"/> Hollow rod <input type="checkbox"/> Jetted <input type="checkbox"/> Bored <input type="checkbox"/> Reverse rotary		8. Use: <input checked="" type="checkbox"/> Domestic <input type="checkbox"/> Public supply <input type="checkbox"/> Industry <input type="checkbox"/> Irrigation <input type="checkbox"/> Air conditioning <input type="checkbox"/> Stock <input type="checkbox"/> Lawn <input type="checkbox"/> Oil field water <input type="checkbox"/> Other													
<table border="1" style="width:100%; border-collapse: collapse;"> <thead> <tr> <th style="width:80%;"></th> <th style="width:10%;">From</th> <th style="width:10%;">To</th> </tr> </thead> <tbody> <tr> <td>TOP SOIL</td> <td>0</td> <td>5</td> </tr> <tr> <td>CLAY, BLUE</td> <td>5</td> <td>49</td> </tr> <tr> <td>FINE SAND-COURSE SAND, GRAVEL</td> <td>49</td> <td>55</td> </tr> </tbody> </table>				From	To	TOP SOIL	0	5	CLAY, BLUE	5	49	FINE SAND-COURSE SAND, GRAVEL	49	55	9. Casing: Material PVC Height: Above or below Threaded _____ Welded _____ Surface 29 in. RMP _____ PVC 9L Weight 2,58 lbs./ft. Dia. 5 in. to 55 ft. depth Wall Thickness: inches or Dia. _____ in. to _____ ft. depth gage No. 279		10. Screen: Manufacturer's name PUMPCO MPI Type PVC Dia. 5 Slo/gauze 20 Length 10 Set between 45 ft. and 55 ft. _____ ft. and _____ ft. Gravel pack? <input checked="" type="checkbox"/> Size range of materials 30X60	
	From	To																
TOP SOIL	0	5																
CLAY, BLUE	5	49																
FINE SAND-COURSE SAND, GRAVEL	49	55																
			11. Static water level: _____ mo./day/yr. 30 ft. below land surface Date 10-4-78		12. Pumping level below land surfaces: _____ ft. after _____ hrs. pumping _____ g.p.m. _____ ft. after _____ hrs. pumping _____ g.p.m. Estimated maximum yield 30 g.p.m.													
			13. Water sample submitted: _____ mo./day/yr. <input type="checkbox"/> Yes <input checked="" type="checkbox"/> No Date _____		14. Well head completion: CAP <input type="checkbox"/> Pitless adapter 24 inches above grade													
			15. Well grouted? <input checked="" type="checkbox"/> With: <input checked="" type="checkbox"/> Neat cement <input type="checkbox"/> Bentonite <input type="checkbox"/> Concrete Depth: From 5 ft. to 15 ft.		16. Nearest source of possible contamination: ft. 150 Direction W Type septic Well disinfected upon completion? <input checked="" type="checkbox"/> Yes <input type="checkbox"/> No													
			17. Pump: <input checked="" type="checkbox"/> Not installed Manufacturer's name _____ Model number _____ HP _____ Volts _____ Length of drop pipe _____ ft. capacity _____ g.p.m. Type: <input type="checkbox"/> Submersible <input type="checkbox"/> Turbine <input type="checkbox"/> Jet <input type="checkbox"/> Reciprocating <input type="checkbox"/> Centrifugal <input type="checkbox"/> Other		18. Elevation:													
19. Remarks: OWNER TO INSTALL SLAB			20. Water well contractor's certification: This well was drilled under my jurisdiction and this report is true to the best of my knowledge and belief. STRADER DRIG Co 182 Business name License No. Address RT1 Holton, KS Signed Dale Askew Date 10-6-78 Authorized representative		18. Elevation: Topography: <input type="checkbox"/> Hill <input type="checkbox"/> Slope <input type="checkbox"/> Upland <input checked="" type="checkbox"/> Valley													

T 9 S R 10 E W 21 SW SW SW W