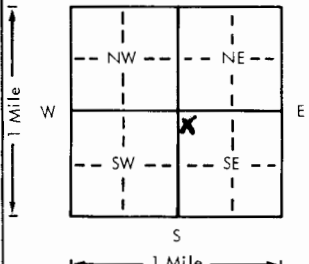


USE TYPEWRITER OR BALL POINT PEN-PRESS FIRMLY, PRINT CLEARLY.

WATER WELL RECORD
KSA 82a-1201-1215

Kansas Department of Health and Environment-Division of Environment
(Water well Contractors)
Topeka, Kansas 66620

1. Location of well: County Pott		Fraction NW SE SE 1/4 SE 1/4 NW 1/4		Section number 21		Township number T 9 S R 10 E/W		Range number 10	
2. Distance and direction from nearest town or city: 3 mi of Wamego Street address of well location in city:				3. Owner of well: Verbie Robinson R.R. or street: Box-2 - Block 21 - Lot 5 City, state, zip code: Louisville KS 66540					
4. Locate with "X" in section below: N W E S 1 Mile				Sketch map: 		6. Bore hole dia. 8 in. Completion date Aug 18-80 Well depth 52 ft.			
5. Type and color of material				From		To		7. <input checked="" type="checkbox"/> Cable tool <input type="checkbox"/> Rotary <input type="checkbox"/> Driven <input type="checkbox"/> Dug <input type="checkbox"/> Hollow rod <input type="checkbox"/> Jetted <input type="checkbox"/> Bored <input type="checkbox"/> Reverse rotary	
								8. Use: <input checked="" type="checkbox"/> Domestic <input type="checkbox"/> Public supply <input type="checkbox"/> Industry <input type="checkbox"/> Irrigation <input type="checkbox"/> Air conditioning <input type="checkbox"/> Stock <input type="checkbox"/> Lawn <input type="checkbox"/> Oil field water <input type="checkbox"/> Other	
Clay Brown				0		5		9. Casing: Material PIST Height: Above or below Threaded <input type="checkbox"/> Welded Percent surface 60 in. RMP <input type="checkbox"/> PVC <input checked="" type="checkbox"/> Weight <input type="checkbox"/> lbs./ft. Dia. 5 in. to 52 ft. depth Wall thickness: inches or Dia. <input type="checkbox"/> in. to <input type="checkbox"/> ft. depth gage No. SC 4.90	
" " " Muddy				5		25		10. Screen: Manufacturer's name Pumpco Type PVC Dia. 5-11 Slot/gauze 1/6 32 Length 28' Set between 52 ft. and 52 ft. Gravel pack? Yes Size range of material 1/8-1/2	
Sand fine				35		40		11. Static water level: 20 ft. below land surface Date 8-18-80 mo./day/yr.	
" " Some Gravel				40		48		12. Pumping level below land surfaces: ____ ft. after ____ hrs. pumping ____ g.p.m. ____ ft. after ____ hrs. pumping ____ g.p.m. Estimated maximum yield ____ g.p.m.	
Shale Blue				48		50		13. Water sample submitted: <input checked="" type="checkbox"/> Yes <input type="checkbox"/> No Date _____ mo./day/yr.	
Lime Rock White				50		52		14. Well head completion: <input type="checkbox"/> Pitless adapter _____ Inches above grade	
								15. Well grouted? YES With: <input checked="" type="checkbox"/> Neat cement <input type="checkbox"/> Bentonite <input checked="" type="checkbox"/> Concrete Depth: From 4 ft. to 14 ft.	
								16. Nearest source of possible contamination: ft. 55' Direction E. Type sewer line Well disinfected upon completion? <input checked="" type="checkbox"/> Yes <input type="checkbox"/> No	
								17. Pump: <input checked="" type="checkbox"/> Not installed Manufacturer's name _____ Model number _____ HP _____ Volts _____ Length of drop pipe _____ ft. capacity ____ g.p.m. Type: <input type="checkbox"/> Submersible <input type="checkbox"/> Turbine <input type="checkbox"/> Jet <input type="checkbox"/> Reciprocating <input type="checkbox"/> Centrifugal <input type="checkbox"/> Other	
(Use a second sheet if needed)									
18. Elevation:		19. Remarks:		20. Water well contractor's certification: This well was drilled under my jurisdiction and this report is true to the best of my knowledge and belief. Harper Dr. Serv. 176 Business name Blue Rapids, KS License No. _____ Address Blue Rapids, KS Signed G. E. Harper Date 8-18-80 Authorized representative					
Topography: <input type="checkbox"/> Hill <input type="checkbox"/> Slope <input type="checkbox"/> Upland <input checked="" type="checkbox"/> Valley									

9-10-21 NW 1/4 NE 1/4