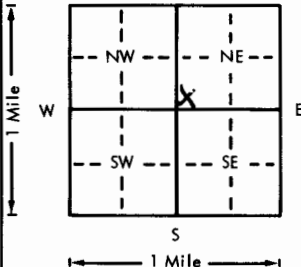


USE TYPEWRITER OR BALL
POINT PEN-PRESS FIRMLY,
PRINT CLEARLY.

WATER WELL RECORD
KSA 82a-1201-1215

Kansas Department of Health and
Environment-Division of Environment
(Water well Contractors)
Topeka, Kansas 66620

1. Location of well:		County POTT	Fraction SW 1/4 SW 1/4 NE 1/4	Section number 26	Township number T 9 S R 10 E	Range number 10 E
2. Distance and direction from nearest town or city: Street address of well location if in city:		1 N - 1 E - 3/4 E 1/2 N of Hamego		3. Owner of well: Isabel Eichen R.R. or street: 9808 Mercer City, state, zip code: Kansas City Mo 64114		
4. Locate with "X" in section below:		Sketch map:		6. Bore hole dia. 3 3/8 in. Completion date 6-8-76 Well depth 78 ft.		
				7. <input type="checkbox"/> Cable tool <input type="checkbox"/> Rotary <input type="checkbox"/> Driven <input type="checkbox"/> Dug <input type="checkbox"/> Hollow rod <input type="checkbox"/> Jetted <input type="checkbox"/> Bored <input checked="" type="checkbox"/> Reverse rotary		
5. Type and color of material		3-29-76		8. Use: <input type="checkbox"/> Domestic <input type="checkbox"/> Public supply <input type="checkbox"/> Industry <input checked="" type="checkbox"/> Irrigation <input type="checkbox"/> Air conditioning <input type="checkbox"/> Stock <input type="checkbox"/> Lawn <input type="checkbox"/> Oil field water <input type="checkbox"/> Other		
				9. Casing: Material AC Height Above or below Threaded <input type="checkbox"/> Welded <input type="checkbox"/> Surface 12 in. RMP <input type="checkbox"/> PVC <input type="checkbox"/> Weight 34 lbs./ft. Dia. 1 1/2 in. to 78 ft. depth Wall Thickness: inches or Dia. <input type="checkbox"/> in. to <input type="checkbox"/> ft. depth Gauge No. 34		
				10. Screen: Manufacturer's name Johnson Concrete Type Transit Dia. 16" Slot/gauge 1/8" Length 26' Set between 52 ft. and 78 ft. ft. and <input type="checkbox"/> ft. Gravel pack? YES Size range of material 4"		
				11. Static water level: <input type="checkbox"/> mo./day/yr. 30 ft. below land surface Date 5-4-76		
				12. Pumping level below land surfaces: 50 ft. after 1/2 hrs. pumping 1250 g.p.m. <input type="checkbox"/> ft. after <input type="checkbox"/> hrs. pumping <input type="checkbox"/> g.p.m. Estimated maximum yield 2500+ g.p.m.		
				13. Water sample submitted: <input type="checkbox"/> mo./day/yr. <input type="checkbox"/> Yes <input checked="" type="checkbox"/> No Date <input type="checkbox"/>		
				14. Well head completion: <input type="checkbox"/> Pitless adapter 12 inches above grade		
				15. Well grouted? YES With: <input type="checkbox"/> Neat cement <input type="checkbox"/> Bentonite <input checked="" type="checkbox"/> Concrete Depth: From 0 ft. to 10 ft.		
				16. Nearest source of possible contamination: ft. 200 Direction NW Type CREEK Well disinfected upon completion? <input type="checkbox"/> Yes <input checked="" type="checkbox"/> No		
				17. Pump: <input type="checkbox"/> Not installed Manufacturer's name WTR Model number 6M HP 25 Volts <input type="checkbox"/> Length of drop pipe 74 ft. capacity 900 g.p.m. Type: <input type="checkbox"/> Submersible <input checked="" type="checkbox"/> Turbine <input type="checkbox"/> Jet <input type="checkbox"/> Reciprocating <input type="checkbox"/> Centrifugal <input type="checkbox"/> Other		
				(Use a second sheet if needed)		
18. Elevation:		19. Remarks:		20. Water well contractor's certification: This well was drilled under my jurisdiction and this report is true to the best of my knowledge and belief. Geo Cox + Sons, Inc 258 Business name Chapman Kansas License No. <input type="checkbox"/> Address Chapman Kansas Signed Isabel Eichen Date 6-14-76 Authorized representative		
Topography: <input type="checkbox"/> Hill <input type="checkbox"/> Slope <input type="checkbox"/> Upland <input checked="" type="checkbox"/> Valley						