

USE TYPEWRITER OR BALL POINT PEN-PRESS FIRMLY, PRINT CLEARLY.


WATER WELL RECORD
KSA 82a-1201-1215

Kansas Department of Health and Environment-Division of Environment (Water well Contractors) Topeka, Kansas 66620

1. Location of well: County **Pottawatomie** Fraction **Ctr. of XX E 1/2 XX SW 1/4** Section number **26** Township number **T 9 S R 10** Range number **10** E/W

2. Distance and direction from nearest town or city: **1/2 mi. E., 1/2 mi. N., 1 mi. E., 1 mi. N., 1/2 mi. E., & 1/2 mi. W. of U.S. 24**
Street address of well location if in city: **in Wamego, Ks.**

3. Owner of well: **Pessemier Farming Co.**
R.R. or street: **St. Marys State Bank Bldg.**
City, state, zip code: **St. Marys, Ks. 66536**

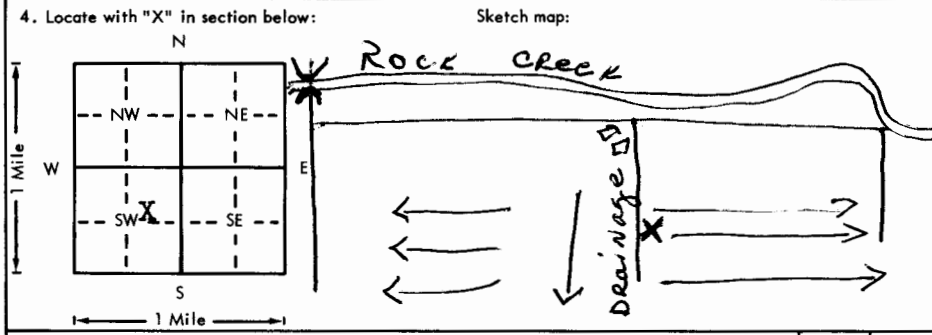

6. Bore hole dia. **30** in. Completion date **4-21-76**
Well depth **71** ft.

7. Cable tool Rotary Driven Dug
 Hollow rod Jetted Bored Reverse rotary

8. Use: Domestic Public supply Industry Irrigation Air conditioning Stock Lawn Oil field water Other

9. Casing: Material **Trans** Height (Above) or below Threading Welded Surface **24** in. RMP PVC Weight lbs./ft. Dia. **16** in. to **45** ft. depth Wall Thickness: inches or Dia. in. to ft. depth Page No. **75**

5. Type and color of material	From	To
Black top soil	0	5
Brown Clay	5	26
Gray Clay	26	47
Medium gray gravel	47	53
Large gray gravel	53	71
Bed rock-stopped	71	
(Use a second sheet if needed)		

10. Screen: Manufacturer's name **Johnson Well**

Type **Transite** Dia. **16"**
Slq/gauze **1/8x8** Length **26'**
Set between **45** ft. and **71** ft.
Gravel pack? **yes** Size range of material **5/8**

11. Static water level: **31** ft. below land surface Date **4-21-76** mo./day/yr.

12. Pumping level below land surfaces:
37 ft. after **1** hrs. pumping **800** g.p.m.
44 ft. after **3** hrs. pumping **1000** g.p.m.
Estimated maximum yield **1500** g.p.m.

13. Water sample submitted: Yes No Date

14. Well head completion: Pitless adapter Inches above grade

15. Well grouted? **yes**
With: Neat cement Bentonite Concrete
Depth: From **0** ft. to **10** ft.

16. Nearest source of possible contamination: **2500** ft. Direction **North** Type **Rock Creek**
Well disinfected upon completion? Yes No

17. Pump: Not installed
Manufacturer's name _____
Model number _____ HP _____ Volts _____
Length of drop pipe _____ ft. capacity _____ g.p.m.
Type: Submersible Turbine Jet Reciprocating Centrifugal Other

18. Elevation:
Topography: Hill Slope Upland Valley

19. Remarks:

20. Water well contractor's certification:
This well was drilled under my jurisdiction and this report is true to the best of my knowledge and belief.
Hoobler Drilling Co. 323
Business name License No. _____
Address **St. Marys, Ks. 66536**
Signed **Don Hoobler** Date **4-21-76**
Authorized representative

T-2
R-100
W-26
S-26
C-SE
1/4 1/4 1/4