

USE TYPEWRITER OR BALL POINT PEN-PRESS FIRMLY, PRINT CLEARLY.


WATER WELL RECORD
KSA 82a-1201-1215

Kansas Department of Health and Environment-Division of Environment
(Water well Contractors)
Topeka, Kansas 66620

Lot # 13

1. Location of well: County Pottawatomie Fraction SW 1/4 SW 1/4 NW 1/4 Section number 28 Township number T 9 S R 10 E/W Range number

2. Distance and direction from nearest town or city: .55 .3 E OF Louisville
3. Owner of well: Larry Bammes
R.R. or street: 606 Maple
City, state, zip code: Wamego, Ks. 66547

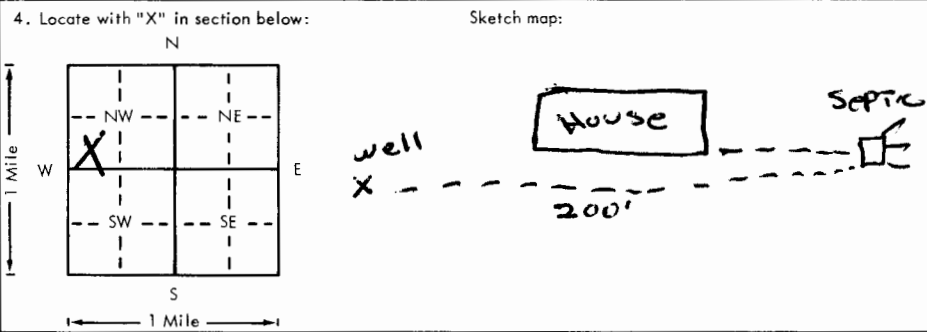

6. Bore hole dia. 12 in. Completion date 8-19-79
Well depth 58 ft.
7. Cable tool Rotary Driven Dug
 Hollow rod Jetted Bored Reverse rotary
8. Use: Domestic Public supply Industry
 Irrigation Air conditioning Stock
 Lawn Oil field water Other
9. Casing: Material PVC Height: Above or below
Threaded Welded Surface 29 in.
RMP PVC 92 Weight 2.82 lbs./ft.
Dia. 5 in. to 58 ft. depth Wall Thickness: inches or
Dia. 5 in. to 58 ft. depth gage No. 258

5. Type and color of material	From	To
<u>TOP SOIL</u>	<u>0</u>	<u>6</u>
<u>Clay, brown</u>	<u>6</u>	<u>15</u>
<u>Five Sand, coarse Sand, water bearing</u>	<u>15</u>	<u>20</u>
<u>shale, grey</u>	<u>20</u>	<u>58</u>
(Use a second sheet if needed)		

10. Screen: Manufacturer's name Pumpco
Type PVC Dia. 5
Slot/gauge .020 Length 10
Set between 15 ft. and 25 ft.
Gravel pack? Size range of material 20-40
11. Static water level: 15 ft. below land surface Date 8-19-79
12. Pumping level below land surfaces:
 ft. after hrs. pumping g.p.m.
 ft. after hrs. pumping g.p.m.
Estimated maximum yield 4 g.p.m.
13. Water sample submitted: mo./day/yr.
 Yes No Date
14. Well head completion: CAPA
24 Inches above grade
15. Well grouted?
With: Neat cement Bentonite Concrete
Depth: From 0 ft. to 10 ft.
16. Nearest source of possible contamination:
ft. 200 Direction E Type SEPTIC
Well disinfected upon completion? Yes No
17. Pump: Not installed
Manufacturer's name
Model number HP Volts
Length of drop pipe ft. capacity g.p.m.
Type:
 Submersible Turbine
 Jet Reciprocating
 Centrifugal Other

18. Elevation: Topography: Hill Slope Upland Valley

19. Remarks: owner to install slab

20. Water well contractor's certification:
This well was drilled under my jurisdiction and this report is true to the best of my knowledge and belief.
STRADER Drlg Co 182
Business name License No.
Address Holtan, Ks
Signed Dale Asher Date
Authorized representative

T-9
R-100
E-28
S-28
SW 1/4 NW 1/4