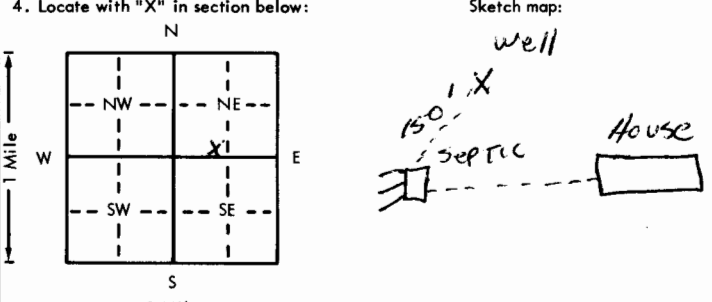


USE TYPEWRITER OR BALL POINT PEN-PRESS FIRMLY, PRINT CLEARLY.

WATER WELL RECORD  
KSA 82a-1201-1215

Kansas Department of Health and Environment-Division of Environment (Water well Contractors) Topeka, Kansas 66620

1. Location of well: County <u>Pottawatomie</u> Fraction <u>SE 1/4 SW 1/4 NE 1/4</u> Section number <u>32</u> Township number <u>T 9 S</u> Range number <u>R 10 E</u>	
2. Distance and direction from nearest town or city: <u>1 N .5 W</u> Street address of well location if in city: <u>OF Wamega</u>	
3. Owner of well: <u>Kennith Bowen</u> R.R. or street: <u>R1</u> City, state, zip code: <u>Wamega, Ks</u>	
4. Locate with "X" in section below: Sketch map: 	
6. Bore hole dia. <u>10</u> in. Completion date <u>7-19-76</u> Well depth <u>105</u> ft.	
7. <input checked="" type="checkbox"/> Cable tool <input checked="" type="checkbox"/> Rotary <input type="checkbox"/> Driven <input type="checkbox"/> Dug <input type="checkbox"/> Hollow rod <input type="checkbox"/> Jetted <input type="checkbox"/> Bored <input type="checkbox"/> Reverse rotary	
8. Use: <input checked="" type="checkbox"/> Domestic <input type="checkbox"/> Public supply <input type="checkbox"/> Industry <input type="checkbox"/> Irrigation <input type="checkbox"/> Air conditioning <input type="checkbox"/> Stock <input type="checkbox"/> Lawn <input type="checkbox"/> Oil field water <input type="checkbox"/> Other	
9. Casing: Material <u>PVC</u> Height: <u>Above</u> or below Threaded <input type="checkbox"/> Welded <input type="checkbox"/> Surface <u>24</u> in. RMP <input type="checkbox"/> PVC <u>9L</u> Weight <u>2.58</u> lbs./ft. Dia <u>5</u> in. to <u>105</u> ft. depth Wall Thickness: inches or Dia. <u>5</u> in. to <u>105</u> ft. depth gage No. <u>214</u>	
10. Screen: Manufacturer's name <u>PUMPCO</u> Type <u>PVC</u> Dia. <u>5</u> Slot/gauze <u>.020</u> Length <u>10</u> Set between <u>95</u> ft. and <u>105</u> ft. ft. and <u>105</u> ft. Gravel pack? <input checked="" type="checkbox"/> Size range of material <u>030X060</u>	
11. Static water level: <u>65</u> ft. below land surface Date <u>7-19-76</u> mo./day/yr.	
12. Pumping level below land surfaces: <u>        </u> ft. after <u>        </u> hrs. pumping <u>        </u> g.p.m. <u>        </u> ft. after <u>        </u> hrs. pumping <u>        </u> g.p.m. Estimated maximum yield <u>30</u> g.p.m.	
13. Water sample submitted: <u>        </u> mo./day/yr. <input type="checkbox"/> Yes <input checked="" type="checkbox"/> No Date <u>        </u>	
14. Well head completion: <u>CAP</u> <input type="checkbox"/> Pitless adapter <u>29</u> inches above grade	
15. Well grouted? <input checked="" type="checkbox"/> With: <input checked="" type="checkbox"/> Neat cement <input type="checkbox"/> Bentonite <input type="checkbox"/> Concrete Depth: From <u>5</u> ft. to <u>15</u> ft.	
16. Nearest source of possible contamination: ft. <u>150</u> Direction <u>SW</u> Type <u>SEPTIC</u> Well disinfected upon completion? <input checked="" type="checkbox"/> Yes <input type="checkbox"/> No	
17. Pump: <input checked="" type="checkbox"/> Not installed Manufacturer's name <u>        </u> Model number <u>        </u> HP <u>        </u> Volts <u>        </u> Length of drop pipe <u>        </u> ft. capacity <u>        </u> g.p.m. Type: <input type="checkbox"/> Submersible <input type="checkbox"/> Turbine <input type="checkbox"/> Jet <input type="checkbox"/> Reciprocating <input type="checkbox"/> Centrifugal <input type="checkbox"/> Other	
(Use a second sheet if needed)	
18. Elevation: Topography: <input checked="" type="checkbox"/> Hill <input type="checkbox"/> Slope <input type="checkbox"/> Upland <input type="checkbox"/> Valley	19. Remarks: <u>OWNER WILL INSTALL SLAB</u>
20. Water well contractor's certification: This well was drilled under my jurisdiction and this report is true to the best of my knowledge and belief. <u>STRAIDER Dalg Co Inc</u> 182 Business name License No. Address <u>R1 HOLLON, KS</u> Signed <u>Dale Becken</u> Date <u>7-30-76</u> Authorized representative	

T-9  
 R-10  
 W-32  
 Sec-SE SW 1/4