


1 LOCATION OF WATER WELL: County: **POTTAWATOMIE** Fraction: **NW 1/4 NW 1/4 SE 1/4** Section Number: **32** Township Number: **T 9 S** Range Number: **R 10 E/W**

Distance and direction from nearest town or city street address of well if located within city?
1/2 west, 1 north of Wamego

2 WATER WELL OWNER: **Jeff Morrisey**
 RR#, St. Address, Box #: **406 Lincoln St.** Board of Agriculture, Division of Water Resources
 City, State, ZIP Code: **Wamego, KS 66547** Application Number:

3 LOCATE WELL'S LOCATION WITH AN "X" IN SECTION BOX:

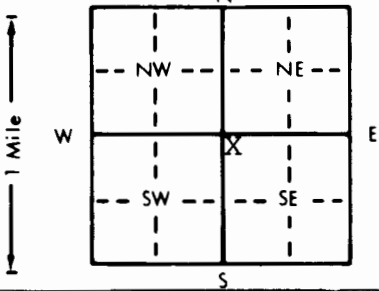

4 DEPTH OF COMPLETED WELL: **100'** ft. ELEVATION: ft.
 Depth(s) Groundwater Encountered 1. ft. 2. ft. 3. ft.
 WELL'S STATIC WATER LEVEL: **72'** ft. below land surface measured on mo/day/yr **1-26-93**
 Pump test data: Well water was ft. after hours pumping gpm
 Est. Yield: **30** gpm: Well water was ft. after hours pumping gpm
 Bore Hole Diameter: **12"** in. to ft., and in. to ft.
 WELL WATER TO BE USED AS:
 1 Domestic 3 Feedlot 6 Oil field water supply 9 Dewatering 12 Other (Specify below)
 2 Irrigation 4 Industrial 7 Lawn and garden only 10 Monitoring well
 Was a chemical/bacteriological sample submitted to Department? Yes.....No.....**X**...; If yes, mo/day/yr sample was submitted
 Water Well Disinfected? Yes **X** No

5 TYPE OF BLANK CASING USED:
 1 Steel 3 RMP (SR) 5 Wrought iron 8 Concrete tile CASING JOINTS: Glued **X** Clamped
 2 PVC 4 ABS 6 Asbestos-Cement 9 Other (specify below) Welded
 7 Fiberglass Threaded
 Blank casing diameter: **5"** in. to **0-90** ft., Dia in. to ft., Dia in. to ft.
 Casing height above land surface: **24"** in., weight **2.82** lbs./ft. Wall thickness or gauge No. **258**

TYPE OF SCREEN OR PERFORATION MATERIAL:
 1 Steel 3 Stainless steel 5 Fiberglass 7 PVC 10 Asbestos-cement
 2 Brass 4 Galvanized steel 6 Concrete tile 8 RMP (SR) 11 Other (specify)
 9 ABS 12 None used (open hole)

SCREEN OR PERFORATION OPENINGS ARE:
 1 Continuous slot 3 Mill slot 5 Gauzed wrapped 8 Saw cut 11 None (open hole)
 2 Louvered shutter 4 Key punched 6 Wire wrapped 9 Drilled holes
 7 Torch cut 10 Other (specify)

SCREEN-PERFORATED INTERVALS: From **90** ft. to **100** ft., From ft. to ft.
 From ft. to ft., From ft. to ft.
 GRAVEL PACK INTERVALS: From **24** ft. to **100** ft., From ft. to ft.
 From ft. to ft., From ft. to ft.

6 GROUT MATERIAL: 1 Neat cement 2 Cement grout 3 Bentonite 4 Other
 Grout Intervals: From **4** ft. to **24** ft., From ft. to ft., From ft. to ft.
 What is the nearest source of possible contamination:
 1 Septic tank 4 Lateral lines 7 Pit privy 10 Livestock pens 14 Abandoned water well
 2 Sewer lines 5 Cess pool 8 Sewage lagoon 11 Fuel storage 15 Oil well/Gas well
 3 Watertight sewer lines 6 Seepage pit 9 Feedyard 12 Fertilizer storage 16 Other (specify below)
 13 Insecticide storage
 Direction from well? **north** How many feet? **165'**

| FROM | TO | LITHOLOGIC LOG | FROM | TO | PLUGGING INTERVALS |
|------|-----|--|------|----|--------------------|
| 0 | 3 | Top Soil | | | |
| 3 | 10 | Clay-Brown-Silty | | | |
| 10 | 24 | Fine Silt-Brown | | | |
| 24 | 52 | Clay-Brown-Silty | | | |
| 52 | 56 | Fine Silt-Brown | | | |
| 56 | 70 | Clay-Brown-Silty | | | |
| 70 | 81 | Fine Sand-Coarse Sand- Brown | | | |
| 81 | 95 | Fine Sand-Coarse Sand-Med-Pea Gravel-Brown | | | |
| 95 | 100 | Chert 1/4x1/2 Fine Sand-Coarse Sand | | | |
| 100 | | Limestone-Grey | | | |

7 CONTRACTOR'S OR LANDOWNER'S CERTIFICATION: This water well was (1) constructed, (2) reconstructed, or (3) plugged under my jurisdiction and was completed on (mo/day/year) **1-26-93** and this record is true to the best of my knowledge and belief. Kansas Water Well Contractor's License No. **182**. This Water Well Record was completed on (mo/day/yr) **2-7-93** under the business name of **STRADER DRILLING CO., INC.** by (signature) *Dallas*