


1 LOCATION OF WATER WELL: Fraction NE 1/4 SW 1/4 NW 1/4 Section Number 33 Township Number T 9 S Range Number R 10 EW
 County: Pottawatomie
 Distance and direction from nearest town or city street address of well if located within city?
1 N Wamego

2 WATER WELL OWNER: Jerry Harriman
 RR#, St. Address, Box #: 56 Trail Ridge Board of Agriculture, Division of Water Resources
 City, State, ZIP Code: Wamego, Kans. 66547 Application Number:

3 LOCATE WELL'S LOCATION WITH AN "X" IN SECTION BOX:

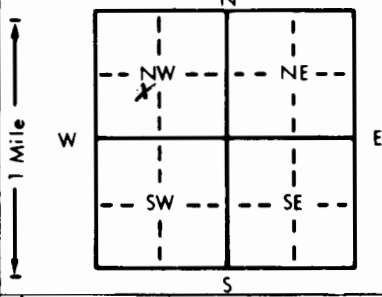

4 DEPTH OF COMPLETED WELL: 54 ft. ELEVATION: ft.
 Depth(s) Groundwater Encountered 1. ft. 2. ft. 3. ft.
 WELL'S STATIC WATER LEVEL 32 ft. below land surface measured on mo/day/yr 12-29-89
 Pump test data: Well water was ft. after hours pumping gpm
 Est. Yield 40 gpm: Well water was ft. after hours pumping gpm
 Bore Hole Diameter... 8 in. to 54 ft., and in. to ft.
 WELL WATER TO BE USED AS: 5 Public water supply 8 Air conditioning 11 Injection well
 Domestic 3 Feedlot 6 Oil field water supply 9 Dewatering 12 Other (Specify below)
 2 Irrigation 4 Industrial 7 Lawn and garden only 10 Monitoring well
 Was a chemical/bacteriological sample submitted to Department? Yes.....No. ; If yes, mo/day/yr sample was submitted
 Water Well Disinfected? Yes No

5 TYPE OF BLANK CASING USED: 5 Wrought iron 8 Concrete tile CASING JOINTS: Glued Clamped
 1 Steel 3 RMP (SR) 6 Asbestos-Cement 9 Other (specify below) Welded
 2 PVC 4 ABS 7 Fiberglass Threaded.....

Blank casing diameter... 5 in. to 32 ft., Dia in. to ft., Dia in. to ft.
 Casing height above land surface... 24 in., weight 200 lbs./ft. Wall thickness or gauge No.

TYPE OF SCREEN OR PERFORATION MATERIAL: 7 PVC 10 Asbestos-cement
 1 Steel 3 Stainless steel 5 Fiberglass 8 RMP (SR) 11 Other (specify)
 2 Brass 4 Galvanized steel 6 Concrete tile 9 ABS 12 None used (open hole)

SCREEN OR PERFORATION OPENINGS ARE: 5 Gauzed wrapped 8 Saw cut 11 None (open hole)
 1 Continuous slot 3 Mill slot 6 Wire wrapped 9 Drilled holes
 2 Louvered shutter 4 Key punched 7 Torch cut 10 Other (specify)

SCREEN-PERFORATED INTERVALS: From... 44 ft. to 54 ft., From ft. to ft.
 From ft. to ft., From ft. to ft.
 GRAVEL PACK INTERVALS: From... 20 ft. to 54 ft., From ft. to ft.
 From ft. to ft., From ft. to ft.

6 GROUT MATERIAL: 1 Neat cement 2 Cement grout 3 Bentonite 4 Other
 Grout Intervals: From... 0 ft. to 20 ft., From ft. to ft., From ft. to ft.

What is the nearest source of possible contamination: 10 Livestock pens 14 Abandoned water well
 1 Septic tank 4 Lateral lines 7 Pit privy 11 Fuel storage 15 Oil well/Gas well
 Sewer lines 5 Cess pool 8 Sewage lagoon 12 Fertilizer storage 16 Other (specify below)
 3 Watertight sewer lines 6 Seepage pit 9 Feedyard 13 Insecticide storage

Direction from well? East How many feet? 120

| FROM | TO | LITHOLOGIC LOG | FROM | TO | PLUGGING INTERVALS |
|-----------|-----------|---------------------------|------|----|--------------------|
| <u>0</u> | <u>20</u> | <u>Brown clay</u> | | | |
| <u>20</u> | <u>35</u> | <u>fine med sand</u> | | | |
| <u>35</u> | <u>36</u> | <u>Brown clay</u> | | | |
| <u>36</u> | <u>52</u> | <u>med to coarse sand</u> | | | |
| <u>52</u> | <u>54</u> | <u>shale</u> | | | |

7 CONTRACTOR'S OR LANDOWNER'S CERTIFICATION: This water well was (1) constructed, (2) reconstructed, or (3) plugged under my jurisdiction and was completed on (mo/day/year) 12-29-89 and this record is true to the best of my knowledge and belief. Kansas Water Well Contractor's License No. 234 This Water Well Record was completed on (mo/day/yr) under the business name of Strader's Blue Valley Drilling by (signature) Betty Jo Strader