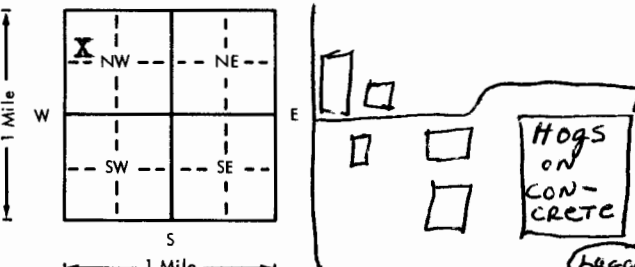


1. Location of well: Pottawatomie		Fraction SW 1/4 NW 1/4 NW 1/4	Section number 35	Township number T 9 S R 10 E/W
2. Distance and direction from nearest town or city: 3 mi. NE of Wamego, Ks. Street address of well location if in city:			3. Owner of well: Everett Boyce R.R. or street: R. R. #2 City, state, zip code: Wamego, Kansas 66547	
4. Locate with "X" in section below: 		6. Bore hole dia. 30 in. Completion date 3-27-76 Well depth 83 ft.		
5. Type and color of material		From	To	7. Cable tool <input type="checkbox"/> Rotary <input type="checkbox"/> Driven <input type="checkbox"/> Dug <input type="checkbox"/> <input type="checkbox"/> Hollow rod <input type="checkbox"/> Jetted <input type="checkbox"/> Bored <input checked="" type="checkbox"/> Reverse rotary
Brown top soil				8. Use: Domestic <input type="checkbox"/> Public supply <input type="checkbox"/> Industry <input type="checkbox"/> <input checked="" type="checkbox"/> Irrigation <input type="checkbox"/> Air conditioning <input type="checkbox"/> Stock <input type="checkbox"/> <input type="checkbox"/> Lawn <input type="checkbox"/> Oil field water <input type="checkbox"/> Other
Brown top soil		0	3	9. Casing: Material Trans Height: Above or below Threaded <input type="checkbox"/> Welded <input type="checkbox"/> Surface <input type="checkbox"/> in. RMP <input type="checkbox"/> PVC <input type="checkbox"/> Weight <input type="checkbox"/> lbs./ft.
Soft brown clay		3	31	Dia. 16 in. to 45 ft. depth <input checked="" type="checkbox"/> Wall Thickness: inches or Dia. <input type="checkbox"/> in. to <input type="checkbox"/> ft. depth <input type="checkbox"/> ft. 175
Fine gray sand		31	32	10. Screens: Manufacturer's name Johnson 1/2" x 1/2" Type <input type="checkbox"/> Dia. 16 " Slot/gauze 1/8 x 8 Length 38 " Set between 83 ft. and 45 ft. ft. and ft.
Medium gray gravel		32	36	Gravel pack? <input checked="" type="checkbox"/> Size range of material 5/8
Medium gray gravel & clay mixed		36	37	11. Static water level: <input type="checkbox"/> mo./day/yr. 29 ft. below land surface Date 3-30-76
Gray clay		37	46	12. Pumping level below land surfaces: 39 ft. after 1 hrs. pumping 1000 g.p.m. 45 ft. after 3 hrs. pumping 1000 g.p.m. Estimated maximum yield 3000 g.p.m.
Gray gravel & clay		46	47	13. Water sample submitted: <input type="checkbox"/> mo./day/yr. Yes <input checked="" type="checkbox"/> No <input type="checkbox"/> Date
Medium gray gravel		47	52	14. Well head completion: <input type="checkbox"/> Pitless adapter <input type="checkbox"/> inches above grade
Large gray gravel & small rocks		52	82	15. Well grouted? yes With: <input type="checkbox"/> Neat cement <input type="checkbox"/> Bentonite <input checked="" type="checkbox"/> Concrete Depth: From 0 ft. to 10 ft.
Large gray gravel & clay		82	83	16. Nearest source of possible contamination: 4000 ft. Direction North Type Creek Well disinfected upon completion? <input type="checkbox"/> Yes <input checked="" type="checkbox"/> No
Gray clay-Stopped		83		17. Pump: <input checked="" type="checkbox"/> Not installed Manufacturer's name <input type="checkbox"/> Model number <input type="checkbox"/> HP <input type="checkbox"/> Volts <input type="checkbox"/> Length of drop pipe <input type="checkbox"/> ft. capacity <input type="checkbox"/> g.p.m. Type: <input type="checkbox"/> Submersible <input type="checkbox"/> Turbine <input type="checkbox"/> Jet <input type="checkbox"/> Reciprocating <input type="checkbox"/> Centrifugal <input type="checkbox"/> Other
(Use a second sheet if needed)				
18. Elevation:	19. Remarks: We do not install pumps.			
Topography: <input type="checkbox"/> Hill <input type="checkbox"/> Slope <input type="checkbox"/> Upland <input checked="" type="checkbox"/> Valley	20. Water well contractor's certification: This well was drilled under my jurisdiction and this report is true to the best of my knowledge and belief. Hoobler Drilling Co. 323 Business name <input type="checkbox"/> License No. <input type="checkbox"/> Address St. Marys, Ks. 66536 Signed Don Hoobler Date 4-6-76 Authorized representative			