


1) LOCATION OF WATER WELL: County: Pottawatomie	Fraction NW 1/4 NW 1/4 SW 1/4	Section Number 28	Township Number T 9 S	Range Number R 11 E XX
---	---	-----------------------------	---------------------------------	----------------------------------

Distance and direction from nearest town or city street address of well if located within city?
Approximately 1 1/2 miles north and 1 1/4 miles west of Belvue

2) WATER WELL OWNER: **Pottawatomie County RWD #4**
 RR#, St. Address, Box #: **24325 Oregon Trail Rd.**
 City, State, ZIP Code: **Belvue, KS 66407**

Board of Agriculture, Division of Water Resources
 Application Number: _____

3) LOCATE WELL'S LOCATION WITH AN "X" IN SECTION BOX

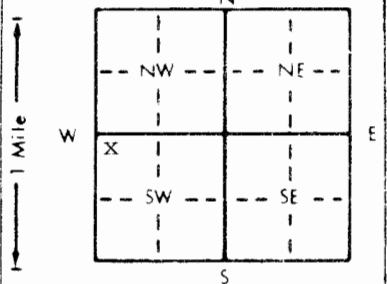

4) DEPTH OF COMPLETED WELL: **71** ft. ELEVATION: **unknown**

Depth(s) Groundwater Encountered: 1 _____ ft. 2 _____ ft. 3 _____ ft.

WELL'S STATIC WATER LEVEL: **18.74** ft. below land surface measured on mo/day yr **4-21-97**

Pump test data: Well water was **not ch'd** ft. after _____ hours pumping _____ gpm

Est. Yield **unknown** gpm Well water was _____ ft. after _____ hours pumping _____ gpm

Bore Hole Diameter: **5** in. to **80** ft. and _____ in. to _____ ft.

WELL WATER TO BE USED AS:

5 Public water supply	8 Air conditioning	11 Injection well
1 Domestic	3 Feedlot	6 Oil field water supply
2 Irrigation	4 Industrial	7 Lawn and garden only
		9 Dewatering
		10 Monitoring well
		12 Other (Specify below)

Observation Well

Was a chemical/bacteriological sample submitted to Department? Yes _____ No X If yes, mo/day/yr sample was submitted _____

Water Well Disinfected? Yes X No _____

5) TYPE OF BLANK CASING USED:

1 Steel	3 RMP (SR)	5 Wrought iron	8 Concrete tile	CASING JOINTS: Glued <input checked="" type="checkbox"/> X Clamped _____
2 PVC	4 ABS	6 Asbestos-Cement	9 Other (specify below)	Welded _____
		7 Fiberglass		Threaded _____

Blank casing diameter: **2** in. to **49** ft. Dia _____ in. to _____ ft. Dia _____ in. to _____ ft.

Casing height above land surface: **24** in. weight **.44** lbs. ft. Wall thickness or gauge No. **.091**

TYPE OF SCREEN OR PERFORATION MATERIAL:

1 Steel	3 Stainless steel	5 Fiberglass	8 RMP (SR)	10 Asbestos-cement
2 Brass	4 Galvanized steel	6 Concrete tile	9 ABS	11 Other (specify)
				12 None used (open hole)

SCREEN OR PERFORATION OPENINGS ARE:

1 Continuous slot	3 Mill slot	5 Gauzed wrapped	8 Saw cut	11 None (open hole)
2 Louvered shutter	4 Key punched	6 Wire wrapped	9 Drilled holes	
		7 Torch cut	10 Other (specify)	

SCREEN-PERFORATED INTERVALS: From **49** ft. to **69** ft. From _____ ft. to _____ ft.

GRAVEL PACK INTERVALS: From **30** ft. to **80** ft. From _____ ft. to _____ ft.

6) GROUT MATERIAL: 1 Neat cement 2 Cement grout 3 Bentonite 4 Other **Bentonite Holeplug**

Grout intervals From _____ ft. to _____ ft. From _____ ft. to _____ ft. From **0** ft. to **30** ft.

What is the nearest source of possible contamination:

1 Septic tank	4 Lateral lines	7 Pit privy	10 Livestock pens	14 Abandoned water well
2 Sewer lines	5 Cess pool	8 Sewage lagoon	11 Fuel storage	15 Oil well/Gas well
3 Watertight sewer lines	6 Seepage pit	9 Feedyard	12 Fertilizer storage	16 Other (specify below)
			13 Insecticide storage	None known

Direction from well? _____ How many feet? _____

FROM	TO	LITHOLOGIC LOG	FROM	TO	PLUGGING INTERVALS
0	2	Topsoil			
2	6	Clay, black, hard			
6	19	Clay, brown, hard			
19	78	Sand and gravel, medium, fine			
78	80	Shale, blue, hard			

7) CONTRACTOR'S OR LANDOWNER'S CERTIFICATION: This water well was (1) constructed, (2) reconstructed, or (3) plugged under my jurisdiction and was completed on (mo/day year) **4-21-97** and this record is true to the best of my knowledge and belief. Kansas Water Well Contractor's License No. **185** This Water Well Record was completed on (mo/day yr) **5-16-97** under the business name of **Clarke Well & Equipment, Inc.** by (signature) *Clarke*