

WATER WELL RECORD

Form WWC-5

Division of Water Resources App. No.


10657

1 LOCATION OF WATER WELL: County: POTT.	Fraction SW ¼ SE ¼ SW ¼ ¼	Section Number 27	Township No. T 9 S	Range Number R 11 <input checked="" type="checkbox"/> E <input type="checkbox"/> W
---	------------------------------	----------------------	-----------------------	---

Street/Rural Address of Well Location; if unknown, distance & direction from nearest town or intersection: If at owner's address, check here .
 BELVUE KS. N. 1/2 MILE E. 1/8 MILE N. 1/2 MILE W. 1/4 MILE

Global Positioning System (GPS) information:
 Latitude: (in decimal degrees)
 Longitude: (in decimal degrees)
 Elevation:
 Datum: WGS 84, NAD 83, NAD 27
 Collection Method:
 GPS unit (Make/Model:)
 Digital Map/Photo, Topographic Map, Land Survey
 Est. Accuracy: <3 m, 3-5 m, 5-15 m, >15 m

2 WATER WELL OWNER: STEVEN HOLZ
 RR#, Street Address, Box #: 22284 WELLS CREEK RD.
 City, State, ZIP Code : BELVUE KS. 66407

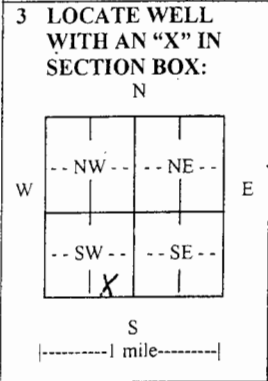

4 DEPTH OF COMPLETED WELL 47 ft.

Depth(s) Groundwater Encountered (1) 18 ft. (2) ft. (3) ft.
 WELL'S STATIC WATER LEVEL 18 ft. below land surface measured on mo/day/yr. 03/05/0
 Pump test data: Well water was NA ft. after hours pumping. 500 gpm
 EST. YIELD 800 gpm. Well water was NA ft. after hours pumping gpm
 Bore Hole Diameter 32 in. to 47 ft., and in. to ft.
 WELL WATER TO BE USED AS: Public water supply Geothermal Injection well
 Domestic Feedlot Oil field water supply Dewatering Other (Specify below)
 Irrigation Industrial Domestic-lawn & garden Monitoring well
 Was a chemical/bacteriological sample submitted to Department? Yes No
 If yes, mo/day/yr sample was submitted
 Water well disinfected? Yes No

5 TYPE OF CASING USED: Steel PVC Other
 CASING JOINTS: Glued Clamped Welded Threaded
 Casing diameter 16 in. to 27 ft., Diameter in. to ft., Diameter in. to ft.
 Casing height above land surface 12 in., Weight lbs./ft., Wall thickness or gauge No. 50
 TYPE OF SCREEN OR PERFORATION MATERIAL:
 Steel Stainless Steel PVC Other (Specify)
 Brass Galvanized Steel None used (open hole)
 SCREEN OR PERFORATION OPENINGS ARE:
 Continuous slot Mill slot Gauze wrapped Torch cut Drilled holes None (open hole)
 Louvered shutter Key punched Wire wrapped Saw cut Other (specify)
 SCREEN-PERFORATED INTERVALS: From 27 ft. to 47 ft., From ft. to ft.
 GRAVEL PACK INTERVALS: From 18 ft. to 47 ft., From ft. to ft.
 From ft. to ft., From ft. to ft.

6 GROUT MATERIAL: Neat cement Cement grout Bentonite Other
 Grout intervals: From 18 ft. to 0 ft., From ft. to ft., From ft. to ft.
 What is the nearest source of possible contamination:
 Septic tank Lateral lines Pit privy Livestock pens Insecticide storage Other (specify below)
 Sewer lines Cesspool Sewage lagoon Fuel storage Abandoned water well
 Watertight sewer lines Seepage pit Feedyard Fertilizer storage Oil well/gas well NONE
 Direction from well Distance from well

FROM	TO	LITHOLOGIC LOG	FROM	TO	LITHO. LOG (cont.) or PLUGGING INTERVALS
0	6	BLACK CLAY/SILT			
6	18	BROWN CLAY			
18	23	BROWN CLAY/MED SAND			
23	30	FINE BROWN SAND			
30	36	MED GREY SAND			
36	47	MED/COARSE SAND			
47		WEATHERED SHALE/STOP			

7 CONTRACTOR'S OR LANDOWNER'S CERTIFICATION: This water well was constructed, reconstructed, or plugged under my jurisdiction and was completed on (mo/day/year) 03/05/09 and this record is true to the best of my knowledge and belief.
 Kansas Water Well Contractor's License No. 782 This Water Well Record was completed on (mo/day/year) 03/09/09
 under the business name of FARMERS UNION VALLEY IRRIGATION by (signature) *Steve Figg*

INSTRUCTIONS: Use typewriter or ball point pen. PLEASE PRESS FIRMLY and PRINT clearly. Please fill in blanks and check the correct answers. Send three copies (white, blue, pink) to Kansas Department of Health and Environment, Bureau of Water, Geology Section, 1000 SW Jackson St., Suite 420, Topeka, Kansas 66612-1367. Telephone 785-296-5522. Send one copy to WATER WELL OWNER and retain one for your records. Include fee of \$5.00 for each constructed well. Visit us at <http://www.kdheks.gov/waterwell/index.html>.