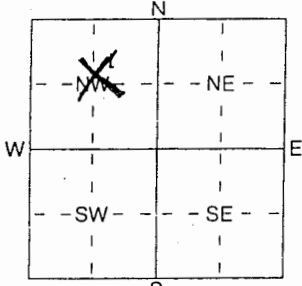


1 LOCATION OF WATER WELL: Fraction **1/4 NW 1/4** Section Number **31** Township Number **T 9 S R 11 E** Range Number **11**
 County: **Pottawatomie**
 Distance and direction from nearest town or city street address of well if located within city? **1 mile NW of Wamego** **Former Forbes Missile Base**
16795 Jay Rd., Wamego, KS 66547

2 WATER WELL OWNER: **US Army Corps of Engineers**
 RR#, St. Address, Box #: **601 East 12th St.** Board of Agriculture, Division of Water Resources
 City, State, ZIP Code: **Kansas City, MO 64106** Application Number:

3 LOCATE WELL'S LOCATION WITH AN "X" IN SECTION BOX:

 4 DEPTH OF COMPLETED WELL: **119** ft. ELEVATION:
 Depth(s) Groundwater Encountered 1 **100** ft. 2 _____ ft. 3 _____ ft.
 WELL'S STATIC WATER LEVEL _____ ft. below land surface measured on mo/day/yr _____
 Pump test data: Well water was _____ ft. after _____ hours pumping _____ gpm
 Est. Yield _____ gpm: Well water was _____ ft. after _____ hours pumping _____ gpm
 WELL WATER TO BE USED AS:
 1 Domestic 3 Feedlot 6 Oil field water supply 9 Dewatering 11 Injection well
 2 Irrigation 4 Industrial 7 Domestic (lawn & garden) 10 Monitoring well **ISCO**

5 TYPE OF BLANK CASING USED:
 1 Steel 3 RMP (SR) 5 Wrought iron 8 Concrete tile CASING JOINTS: Glued _____ Clamped _____
 2 **PVC** 4 ABS 7 Fiberglass 9 Other (specify below) Welded _____
 Blank casing diameter **4"** in. to _____ ft., Dia _____ in. to _____ ft., Dia _____ in. to _____ ft.
 Casing height above land surface **30"** in., weight _____ lbs./ft. Wall thickness or gauge No. _____
 TYPE OF SCREEN OR PERFORATION MATERIAL:
 1 Steel 3 Stainless Steel 5 Fiberglass 7 **PVC** 10 Asbestos-Cement
 2 Brass 4 Galvanized Steel 6 Concrete tile 9 ABS 11 Other (Specify) _____
 12 None used (open hole)

SCREEN OR PERFORATION OPENINGS ARE:
 1 Continuous slot 2 Louvered shutter 3 **Mill slot** 4 Key punched 5 Gauzed wrapped 6 Wire wrapped 7 Torch cut 8 Saw cut 9 Drilled holes 10 Other (specify) _____ ft.
 SCREEN-PERFORATED INTERVALS: From **99** ft. to **119** ft. From _____ ft. to _____ ft.
 GRAVEL PACK INTERVALS: From **96** ft. to **119** ft. From _____ ft. to _____ ft.

6 GROUT MATERIAL: 1 **Neat cement** 2 Cement grout 3 Bentonite 4 Other _____
 Grout intervals: From **0** ft. to **90** ft. From _____ ft. to _____ ft.
 What is the nearest source of possible contamination:
 1 Septic tank 4 Lateral lines 7 Pit privy 10 Livestock pens 14 Abandoned water well
 2 Sewer lines 5 Cess pool 8 Sewage lagoon 11 Fuel storage 15 Oil well/Gas well
 3 Watertight sewer lines 6 Seepage pit 9 Feedyard 12 Fertilizer storage 16 Other (specify below)
 13 Insecticide storage
 Direction from well? _____ How many feet? _____

FROM	TO	LITHOLOGIC LOG	FROM	TO	PLUGGING INTERVALS
0	119	Sand + Clay Layered			

CONTRACTOR'S OR LANDOWNER'S CERTIFICATION: This water well was (1) constructed, (2) reconstructed, or (3) plugged under my jurisdiction and was completed on (mo/day/year) **8/6/10** and this record is true to the best of my knowledge and belief. Kansas Water Well Contractor's Licence No. **597** This Water Well Record was completed on (mo/day/yr) _____ under the business name of **Baart Longyear** by signature 