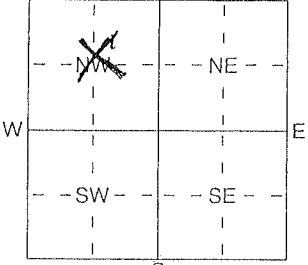


1 LOCATION OF WATER WELL: Fraction $\frac{1}{4}$ $\frac{1}{4}$ **NW** $\frac{1}{4}$ Section Number **31** Township Number T **9** S Range Number R **11** **EW**
 County: **Pottawatomie**

Distance and direction from nearest town or city street address of well if located within city? **1 mile NW of Wamego** **Former Forbes Missile Base**
16795 Jay Rd., Wamego, KS 66547

2 WATER WELL OWNER: **US Army Corps of Engineers**
 RR#, St. Address, Box #: **601 East 12th St.** Board of Agriculture, Division of Water Resources
 City, State, ZIP Code: **Kansas City, MO 64106** Application Number:

3 LOCATE WELL'S LOCATION WITH AN "X" IN SECTION BOX:

 4 DEPTH OF COMPLETED WELL **110** ft. ELEVATION:
 Depth(s) Groundwater Encountered 1 **90** ft. 2 ft. 3 ft.
 WELL'S STATIC WATER LEVEL ft. below land surface measured on mo/day/yr
 Pump test data: Well water was ft. after hours pumping gpm
 Est. Yield gpm: Well water was ft. after hours pumping gpm
 WELL WATER TO BE USED AS:
 1 Domestic 2 Irrigation 3 Feedlot 4 Industrial 5 Public water supply 6 Oil field water supply 7 Domestic (lawn & garden) 8 Air conditioning 9 **Dewatering** 10 **Monitoring well** 11 Injection well 12 Other (Specify below)

5 TYPE OF BLANK CASING USED:
 1 Steel 2 **PVC** 3 RMP (SR) 4 ABS 5 Wrought iron 6 Asbestos-Cement 7 Fiberglass 8 Concrete tile 9 Other (specify below)
 CASING JOINTS: Glued Clamped Welded Threaded **X**
 Blank casing diameter **4"** in. to ft., Dia in. to ft., Dia in. to ft.
 Casing height above land surface **30** in., weight lbs./ft. Wall thickness or gauge No.
 TYPE OF SCREEN OR PERFORATION MATERIAL:
 1 Steel 2 Brass 3 Stainless Steel 4 Galvanized Steel 5 Fiberglass 6 Concrete tile 7 **PVC** 8 RMP (SR) 9 ABS 10 Asbestos-Cement 11 Other (Specify) 12 None used (open hole)
 SCREEN OR PERFORATION OPENINGS ARE:
 1 Continuous slot 2 Louvered shutter 3 **Mill slot** 4 Key punched 5 Gauzed wrapped 6 Wire wrapped 7 Torch cut 8 Saw cut 9 Drilled holes 10 Other (specify) 11 None (open hole)
 SCREEN-PERFORATED INTERVALS: From **90** ft. to **110** ft., From ft. to ft.
 GRAVEL PACK INTERVALS: From **87** ft. to **110** ft., From ft. to ft.

6 GROUT MATERIAL: 1 **Neat cement** 2 Cement grout 3 Bentonite 4 Other
 Grout Intervals: From **0** ft. to **84** ft., From ft. to ft.
 What is the nearest source of possible contamination:
 1 Septic tank 2 Sewer lines 3 Watertight sewer lines 4 Lateral lines 5 Cess pool 6 Seepage pit 7 Pit privy 8 Sewage lagoon 9 Feedyard 10 Livestock pens 11 Fuel storage 12 Fertilizer storage 13 Insecticide storage 14 Abandoned water well 15 Oil well/Gas well 16 Other (specify below)

Direction from well? How many feet?

FROM	TO	LITHOLOGIC LOG	FROM	TO	PLUGGING INTERVALS
0	61	Sand + Clay			
61	110	Sand			

7 CONTRACTOR'S OR LANDOWNER'S CERTIFICATION: This water well was (1) constructed, (2) reconstructed, or (3) plugged under my jurisdiction and was completed on (mo/day/year) **7/9/10** and this record is true to the best of my knowledge and belief. Kansas Water Well Contractor's Licence No **597**. This Water Well Record was completed on (mo/day/year) under the business name of **Boart Longyear** by (signature) 