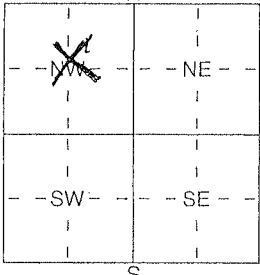


1 LOCATION OF WATER WELL: Fraction  $\frac{1}{4}$   $\frac{1}{4}$  NW  $\frac{1}{4}$  Section Number **31** Township Number T **9** S Range Number R **11** E  
 County: **Pottawatomie**

Distance and direction from nearest town or city street address of well if located within city? **1 mile NW of Wamego**  
**Former Forbes Missile Base**  
**16795 Say Rd., Wamego, KS 66547**


2 WATER WELL OWNER: **US Army Corps of Engineers**  
 RR#, St. Address, Box # : **601 East 12th St.**  
 City, State, ZIP Code : **Kansas City, MO 64106**  
 Board of Agriculture, Division of Water Resources  
 Application Number:

3 LOCATE WELL'S LOCATION WITH AN "X" IN SECTION BOX:  
  
 4 DEPTH OF COMPLETED WELL **94** ft. ELEVATION:  
 Depth(s) Groundwater Encountered 1 **80** ft. 2 ..... ft. 3 ..... ft.  
 WELL'S STATIC WATER LEVEL ..... ft. below land surface measured on mo/day/yr  
 Pump test data: Well water was ..... ft. after ..... hours pumping ..... gpm  
 Est. Yield ..... gpm: Well water was ..... ft. after ..... hours pumping ..... gpm  
 WELL WATER TO BE USED AS:  
 1 Domestic 2 Irrigation 3 Feedlot 4 Industrial 5 Public water supply 6 Oil field water supply 7 Domestic (lawn & garden) 8 Air conditioning 9 **Dewatering** 10 **Monitoring well** 11 Injection well 12 Other (Specify below)

5 TYPE OF BLANK CASING USED:  
 1 **PVC** 2 Steel 3 RMP (SR) 4 ABS 5 Wrought iron 6 Asbestos-Cement 7 Fiberglass 8 Concrete tile 9 Other (specify below)  
 Blank casing diameter **4"** in. to ..... ft., Dia ..... in. to ..... ft., Dia ..... in. to ..... ft.  
 Casing height above land surface **30** in., weight ..... lbs./ft. Wall thickness or gauge No. ....  
 TYPE OF SCREEN OR PERFORATION MATERIAL:  
 1 Steel 2 Brass 3 Stainless Steel 4 Galvanized Steel 5 Fiberglass 6 Concrete tile 7 **PVC** 8 RMP (SR) 9 ABS 10 Asbestos-Cement 11 Other (Specify) 12 None used (open hole)  
 SCREEN OR PERFORATION OPENINGS ARE:  
 1 Continuous slot 2 Louvered shutter 3 **Mill slot** 4 Key punched 5 Gauzed wrapped 6 Wire wrapped 7 Torch cut 8 Saw cut 9 Drilled holes 10 Other (specify) ..... ft. 11 None (open hole)  
 SCREEN-PERFORATED INTERVALS: From **74** ft. to **94** ft., From ..... ft. to ..... ft.  
 GRAVEL PACK INTERVALS: From **72** ft. to **94** ft., From ..... ft. to ..... ft.

6 GROUT MATERIAL: 1 **Neat cement** 2 Cement grout 3 Bentonite 4 Other .....  
 Grout Intervals: From **0** ft. to **67** ft., From ..... ft. to ..... ft.  
 What is the nearest source of possible contamination:  
 1 Septic tank 2 Sewer lines 3 Watertight sewer lines 4 Lateral lines 5 Cess pool 6 Seepage pit 7 Pit privy 8 Sewage lagoon 9 Feedyard 10 Livestock pens 11 Fuel storage 12 Fertilizer storage 13 Insecticide storage 14 Abandoned water well 15 Oil well/Gas well 16 Other (specify below)  
 Direction from well? ..... How many feet? .....

FROM	TO	LITHOLOGIC LOG	FROM	TO	PLUGGING INTERVALS
0	71	<del>800000</del> Sandy & silty clay			
71	94	Sand & Gravel			

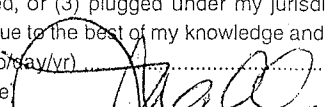7 CONTRACTOR'S OR LANDOWNER'S CERTIFICATION: This water well was (1) constructed, (2) reconstructed, or (3) plugged under my jurisdiction and was completed on (mo/day/year) **8/27/10** and this record is true to the best of my knowledge and belief. Kansas Water Well Contractor's Licence No. **597** This Water Well Record was completed on (mo/day/yr) ..... under the business name of **Boart Longyear** by (signature) 

INSTRUCTIONS: Use typewriter or ball point pen. PLEASE PRESS FIRMLY and PRINT clearly. Please fill in blanks, underline or circle the correct answers. Send log three copies to Kansas Department of Health and Environment, Bureau of Water, Geology Section, 1000 SW Jackson St., Suite 420, Topeka, Kansas 66612-1367. Telephone 785-296-5522. Send one to WATER WELL OWNER and retain one for your records. Fee of \$5.00 for each constructed well.