


1 LOCATION OF WATER WELL: Fraction SW 1/4 SE 1/4 SW 1/4 Section Number 27 Township Number T 9 S Range Number 11 EW
 County: Pott.

Distance and direction from nearest town or city street address of well if located within city?
Belvue, KS N 1/2 mile, E 1/8 mile, N 1/2 Mile, W 3/16 Mile

2 WATER WELL OWNER: Steven Holz Global Positioning Systems (decimal degrees, min. of 4 digits)
 RR#, St. Address, Box #: 22284 Wells Creek Rd Latitude: _____
 City, State ZIP Code: Belvue, KS 66407 Longitude: _____
 Elevation: _____
 Datum: _____
 Data Collection Method: _____

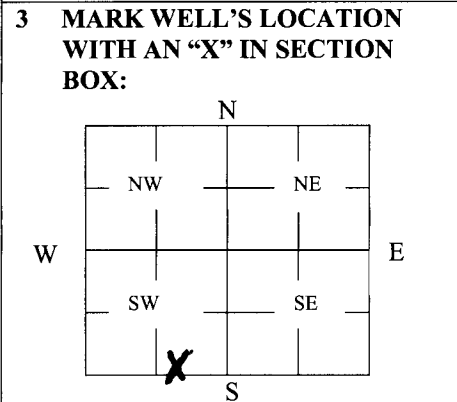

4 DEPTH OF WELL 47 ft.
 WELL'S STATIC WATER LEVEL 18 ft.
 WELL WAS USED AS:
 1 Domestic 5 Public Water Supply 9 Dewatering
 2 Irrigation 6 Oil Field Water Supply 10 Monitoring
 3 Feedlot 7 Domestic (Lawn & Garden) 11 Injection Well
 4 Industrial 8 Air Conditioning 12 Other _____
 Was a chemical/bacteriological sample submitted to Department? Yes _____ No

5 TYPE OF BLANK CASING USED:
 1 Steel 3 RMP (SR) 5 Wrought 7 Fiberglass 9 Other (Specify below)
 2 PVC 4 ABS 6 Asbestos-Cement 8 Concrete Tile
 Blank casing diameter 16 in. Was casing pulled? Yes _____ No If yes, how much Cut off
 Casing height above or below land surface 84 in. 7 ft Below surface

6 GROUT PLUG MATERIAL: 1 Neat cement 2 Cement grout 3 Bentonite 4 Other _____
 Grout Plug Intervals: From 47 ft. to 9 ft., From 9 ft. to 7 ft., From 7 to 5 ft.
 What is the nearest source of possible contamination:
 1 Septic tank 6 Seepage pit 11 Fuel Storage 16 Other (specify below)
 2 Sewer lines 7 Pit privy 12 Fertilizer storage
 3 Watertight sewer lines 8 Sewage lagoon 13 Insecticide storage
 4 Lateral lines 9 Feedyard 14 Abandoned water well Direction from well? _____
 5 Cess pool 10 Livestock pens 15 Oil well/Gas well How many feet? _____

FROM	TO	PLUGGING MATERIALS	FROM	TO	PLUGGING MATERIALS
<u>47</u>	<u>9</u>	<u>Sand</u>			
<u>9</u>	<u>7</u>	<u>Bentonite in Casing</u>			
<u>7</u>	<u>5</u>	<u>Bentonite Mushroomed over & around casing</u>			
<u>5</u>	<u>3</u>	<u>clay packed</u>			
<u>3</u>	<u>0</u>	<u>Top Soil Replaced</u>			

7 CONTRACTOR'S OR LANDOWNER'S CERTIFICATION: This water well was plugged under my jurisdiction and was completed on (mo/day/year) 11-1-2011 and this record is true to the best of my knowledge and belief. Kansas Water Well Contractor's License No. _____ This Water Well Record was completed on (mo/day/year) _____ under the business name of _____ by (signature) Steven R Holz