USE TYPEWRITER OR BALL POINT PEN-PRESS FIRMLY, PRINT CLEARLY.

WATER WELL RECORD
KSA 82a-1201-1215

Kansas Department of Health and Environment-Division of Environment
(Water well Contractors)
Topeka, Kansas 66620

1. Location of well:	County	Fraction	Section number	Township number	Range number
	Pottawatomie	SW 1/4 SW 1/4 SW 1/4	5	T 9 (S)	R 11 (E) W

2. Distance and direction from nearest town or city: 3.5 E 5 N
Street address of well location if in city: .5 E of Wamego

3. Owner of well: Dale Bailey
R.R. or street:
City, state, zip code: RRI Belvue, Ks. 66407

4. Locate with "X" in section below:

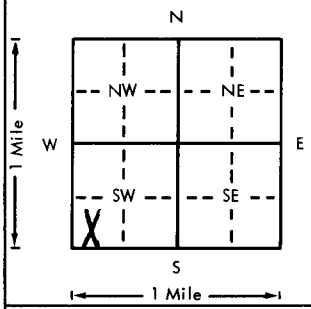

Sketch map:

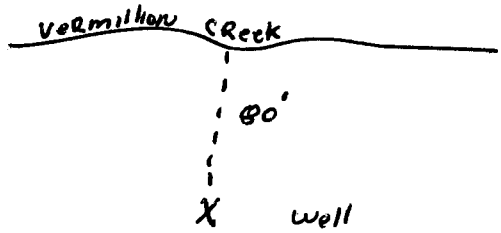

6. Bore hole dia. 12 in. Completion date
Well depth 44 ft. 10-9-78

7. __ Cable tool ✓ Rotary __ Driven __ Dug
__ Hollow rod __ Jetted __ Bored __ Reverse rotary

8. Use: ✓ Domestic __ Public supply __ Industry
__ Irrigation __ Air conditioning __ Stock
__ Lawn __ Oil field water __ Other

9. Casing: Material PVC Height: Above or below
Threaded ___ Welded ___ Surface 24 in.
RMP ___ PVC 96 Weight 2.50 lbs./ft.
Dia. 5 in. to 44 ft. depth Wall Thickness: inches or
Dia. ___ in. to ___ ft. depth gage No. 1279

10. Screen: Manufacturer's name
Pumpco MPI
Type PVC Dia. 10
Slot/gauze .020 Length ~~25~~ 10
Set between 34 ft. and 44 ft.
___ ft. and ___ ft.
Gravel pack? ✓ Size range of material .030x.060

11. Static water level: mo./day/yr.
35 ft. below land surface Date 10-9-78

12. Pumping level below land surfaces:
___ ft. after ___ hrs. pumping ___ g.p.m.
___ ft. after ___ hrs. pumping ___ g.p.m.
Estimated maximum yield 1½ g.p.m.

13. Water sample submitted: mo./day/yr.
___ Yes ✓ No Date

14. Well head completion: CAP
___ Pitless adapter 24 Inches above grade

15. Well grouted? ✓
With: ✓ Neat cement ___ Bentonite ___ Concrete
Depth: From 5 ft. to 15 ft.

16. Nearest source of possible contamination:
ft. 80 Direction N Type Creek
Well disinfected upon completion? ✓ Yes ___ No

17. Pump: ✓ Not installed
Manufacturer's name
Model number ___ HP ___ Volts ___
Length of drop pipe ___ ft. capacity ___ g.p.m.
Type:
___ Submersible ___ Turbine
___ Jet ___ Reciprocating
___ Centrifugal ___ Other

5. Type and color of material	From	To
Top Soil	0	6
Clay, Blue	6	35
Fine Sand- Course Sand	35	36
Shale, gray	36	44

(Use a second sheet if needed)

18. Elevation:
Topography:
___ Hill
___ Slope
___ Upland
✓ Valley

19. Remarks:
owner to install slab

20. Water well contractor's certification:
This well was drilled under my jurisdiction and this report is true to the best of my knowledge and belief.
Strader Drlg Co 182
Business name License No.
Address RT 1 Holton, Ks
Signed Dale Bailey Date 10-11-78
Authorized representative

T 9 R 11 E W Sec 5 1/4 1/4 1/4 1/4 SW SW SW

Forward the white, blue and pink copies to the Department of Health and Environment

Form WWC-5

MI-1023