


1 LOCATION OF WATER WELL: County: POTTAWATOMIE Fraction: SW 1/4 SW 1/4 NW 1/4 Section Number: 6 Township Number: T 9 S Range Number: R 11 EW

Distance and direction from nearest town or city street address of well if located within city? 2 1/2 west, 6 north of Belvue

2 WATER WELL OWNER: Peterson Farms RR#, St. Address, Box # Rt. 2 City, State, ZIP Code Wamego, KS 66547 Board of Agriculture, Division of Water Resources Application Number:

3 LOCATE WELL'S LOCATION WITH AN "X" IN SECTION BOX. 4 DEPTH OF COMPLETED WELL 55' ELEVATION: WFLUS STATIC WATER LEVEL 22' below land surface measured on mo/day/yr 10-18-89

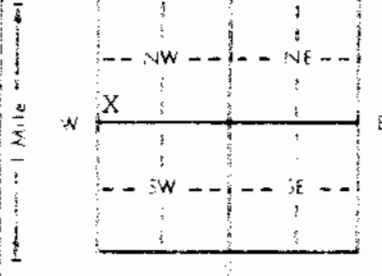

Depth(s) Groundwater Encountered: 1, 2, 3 WFLUS STATIC WATER LEVEL 22' Pump test data: Well water was Est. Yield 25 gpm: Well water was Bore Hole Diameter 12" WELL WATER TO BE USED AS: 1 Domestic, 2 Irrigation, 3 Feedlot, 4 Industrial, 5 Public water supply, 6 Oil field water supply, 7 Lawn and garden only, 8 Air conditioning, 9 Dewatering, 10 Monitoring well, 11 Injection well, 12 Other (Specify below) Was a chemical/bacteriological sample submitted to Department? Yes No X if yes mo/day/yr sample was submitted

5 TYPE OF BLANK CASING USED: 1 Steel, 2 PVC, 3 RMP (SR), 4 ABS, 5 Aluminum, 6 Concrete tile, 7 Asbestos-Cement, 8 Other (specify below), 9 Fiberglass, 10 Other (specify below) CASING JOINTS: 11 Gasket, 12 Glued, 13 Welded, 14 Other (specify below)

Blank casing diameter 5" Casing height above land surface 24" Casing weight 2.82 lbs/ft Wall thickness or gauge No. .258

TYPE OF SCREEN OR PERFORATION MATERIAL: 1 Steel, 2 Brass, 3 Stainless steel, 4 Galvanized steel, 5 Fiberglass, 6 Concrete tile, 7 PVC .030, 8 RMP (SR), 9 ABS, 10 Asbestos-cement, 11 Other (specify), 12 Other (specify) (one hole)

SCREEN OR PERFORATION OPENINGS ARE: 1 Continuous slot, 2 Louvered shutter, 3 Mill slot, 4 Key punched, 5 Gauzed wrapped, 6 Wire wrapped, 7 Torch cut, 8 Saw cut, 9 Drilled holes, 10 Other (specify)

SCREEN PERFORATED INTERVALS: From 43 ft to 53 ft GRAVEL PACK INTERVALS: From 24 ft to 55 ft

6 GROUT MATERIAL: 1 Neat cement, 2 Cement grout, 3 Bentonite, 4 Other hole plug Grout intervals: From 4 ft to 24 ft

What is the nearest source of possible contamination: 1 Septic tank, 2 Sewer lines, 3 Watertight sewer lines, 4 Lateral lines, 5 Cess pool, 6 Seepage pit, 7 Pit privy, 8 Sewage lagoon, 9 Feedyard, 10 Livestock pens, 11 Fuel storage, 12 Fertilizer storage, 13 Insecticide storage, 14 Abandoned water well, 15 Oil well/Gas well, 16 Other (specify below)

Direction from well? North How many feet? 500'

Table with columns: FROM, TO, LITHOLOGIC LOG, FROM, TO, PLUGGING INTERVALS. Rows: 0-45 Clay-Brown, 45-48 Fine Sand-Coarse Sand-Med-Pea Gravel, Blue, 48-55 Shale-Grey

7 CONTRACTOR'S OR LANDOWNER'S CERTIFICATION. This water well was (1) constructed, (2) reconstructed, or (3) plugged under my jurisdiction and was completed on (mo/day/year) 10-18-89 and this record is true to the best of my knowledge and belief. Kansas Water Well Contractor's License No. 182 This Water Well Record was completed on (mo/day/yr) 11-15-89 under the business name of STRADER DRILLING CO., INC. by (signature) [Signature]

INSTRUCTIONS: Use typewriter or ball point pen. PLEASE PRESS FIRMLY and PRINT clearly. Please fill in blanks, underline or circle the correct answers. Send two copies to Kansas Department of Health and Environment, Bureau of Water Protection, Topeka, Kansas 66620-5420. Telephone: 813-296-5514. Send one to WATER WELL OWNER and retain one for your records.