


USE TYPEWRITER OR BALL POINT PEN-PRESS FIRMLY, PRINT CLEARLY.

WATER WELL RECORD
KSA 82a-1201-1215

Kansas Department of Health and Environment-Division of Environment
(Water well Contractors)
Topeka, Kansas 66620

1. Location of well: County PITAWATONIC Fraction NE 1/4 NE 1/4 NE 1/4 Section number 19 Township number T 9 S R 11 Range number 11 QW

2. Distance and direction from nearest town or city: 4 E - 20'
Street address of well location if in city: OF WAMEYO
3. Owner of well: GARY E. SLAIGLE
R.R. or street:
City, state, zip code: RRI WAMEYO

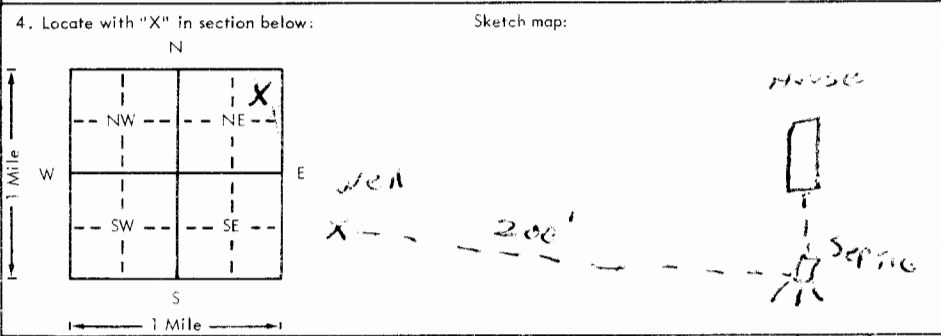

6. Bore hole dia. 5" in. Completion date _____
Well depth 100 ft. 7-15-77

7. Cable tool Rotary Driven Dug
 Hollow rod Jetted Bored Reverse rotary

8. Use: Domestic Public supply Industry
 Irrigation Air conditioning Stock
 Lawn Oil field water Other

9. Casing: Material PVC Height: Above or below
Threaded _____ Welded _____ Surface 24 in.
RMP _____ PVC 40 Weight 250 lbs./ft.
Dia. 5 in. to 100 ft. depth Wall Thickness: inches or
Dia. _____ in. to _____ ft. depth gage No. 258

| 5. Type and color of material | From | To |
|-------------------------------|-----------|------------|
| <u>Top Soil</u> | <u>0</u> | <u>3</u> |
| <u>Sandy Clay, Brown</u> | <u>3</u> | <u>25</u> |
| <u>Limestone, yellow</u> | <u>45</u> | <u>52</u> |
| <u>Shale, grey, Red</u> | <u>52</u> | <u>100</u> |

10. Screen: Manufacturer's name _____
PUMPER, MBL

Type PVC Dia. 5
Slot/gauze 200 Length 20
Set between 40 ft. and 60 ft.
_____ ft. and _____ ft.

Gravel pack? Size range of material: 3/4" x 1/2"

11. Static water level: _____ mo./day/yr.
45 ft. below land surface Date 7-15-77

12. Pumping level below land surfaces:
_____ ft. after _____ hrs. pumping _____ g.p.m.
_____ ft. after _____ hrs. pumping _____ g.p.m.
Estimated maximum yield _____ g.p.m.

13. Water sample submitted: _____ mo./day/yr.
Yes No Date _____

14. Well head completion: CAP
_____ Pitless adapter 24 inches above grade

15. Well grouted?
With: Neat cement Bentonite Concrete
Depth: From 5 ft. to 12 ft.

16. Nearest source of possible contamination: _____
ft. 200 Direction E Type SEPTIC
Well disinfected upon completion? Yes No

17. Pump: Not installed
Manufacturer's name _____
Model number _____ HP _____ Volts _____
Length of drop pipe _____ ft. capacity _____ g.p.m.
Type:
 Submersible Turbine
 Jet Reciprocating
 Centrifugal Other

18. Elevation:
Topography:
 Hill
 Slope
 Upland
 Valley

19. Remarks:
OWNE TO INSTAL SIGN

20. Water well contractor's certification:
This well was drilled under my jurisdiction and this report is true to the best of my knowledge and belief.
Business name STANLEY Dalg Co Inc 182
Address Holtan KS
Signed Dale G. ... Date 7-15-77
Authorized representative