


1 LOCATION OF WATER WELL: Fraction SE 1/4 NW 1/4 NE 1/4 Section Number 25 Township Number T 9 S Range Number R 11 EW

Distance and direction from nearest town or city street address of well if located within city?  
 Dam Station 24+00, 125' Rt

2 WATER WELL OWNER: Kanas Power & Light  
 RR#, St. Address, Box # : 818 Kansas Avenue Board of Agriculture, Division of Water Resources  
 City, State, ZIP Code : Topeka, Kansas 66612 Application Number:

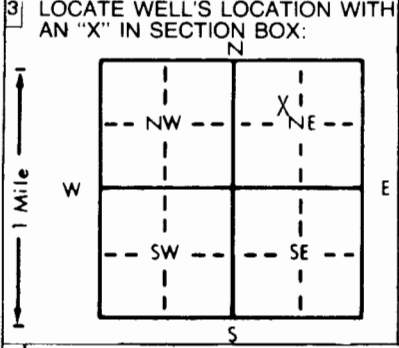

4 DEPTH OF COMPLETED WELL 39.5 ft. ELEVATION: 1075.1  
 Depth(s) Groundwater Encountered 1. Dry ft. 2. ft. 3. ft.  
 WELL'S STATIC WATER LEVEL Dry ft. below land surface measured on mo/day/yr 6-11-86  
 Pump test data: Well water was ft. after hours pumping gpm  
 Est. Yield gpm: Well water was ft. after hours pumping gpm  
 Bore Hole Diameter 6 in. to 39.5 ft. and in. to ft.  
 WELL WATER TO BE USED AS:  
 5 Public water supply 8 Air conditioning 11 Injection well  
 1 Domestic 3 Feedlot 6 Oil field water supply 9 Dewatering 12 Other (Specify below)  
 2 Irrigation 4 Industrial 7 Lawn and garden only 10 Observation well  
 Was a chemical/bacteriological sample submitted to Department? Yes No X; If yes, mo/day/yr sample was submitted Water Well Disinfected? Yes No X

5 TYPE OF BLANK CASING USED:  
 1 Steel 3 RMP (SR) 5 Wrought iron 8 Concrete tile CASING JOINTS: Glued Clamped  
 2 PVC 4 ABS 6 Asbestos-Cement 9 Other (specify below) Welded  
 7 Fiberglass Threaded yes  
 Blank casing diameter 1 1/2 in. to 36.5 ft. Dia. in. to ft. Dia. in. to ft.  
 Casing height above land surface 60 in. weight lbs./ft. Wall thickness or gauge No.  
 TYPE OF SCREEN OR PERFORATION MATERIAL:  
 1 Steel 3 Stainless steel 5 Fiberglass 7 PVC 10 Asbestos-cement  
 2 Brass 4 Galvanized steel 6 Concrete tile 8 RMP (SR) 11 Other (specify)  
 9 ABS 12 None used (open hole)  
 SCREEN OR PERFORATION OPENINGS ARE:  
 1 Continuous slot 3 Mill slot 5 Gauzed wrapped 7 Saw cut 11 None (open hole)  
 2 Louvered shutter 4 Key punched 6 Wire wrapped 9 Drilled holes  
 7 Torch cut 10 Other (specify)  
 SCREEN-PERFORATED INTERVALS: From 36.5 ft. to 39.0 ft. From ft. to ft.  
 GRAVEL PACK INTERVALS: From 34.0 ft. to 39.5 ft. From ft. to ft.

6 GROUT MATERIAL: 1 Neat cement 2 Cement grout 3 Bentonite 4 Other Sand Mix Concrete  
 Grout Intervals: From 0.0 ft. to 31.0 ft. From 31.0 ft. to 34.0 ft. From ft. to ft.  
 What is the nearest source of possible contamination:  
 1 Septic tank 4 Lateral lines 7 Pit privy 10 Livestock pens 14 Abandoned water well  
 2 Sewer lines 5 Cess pool 8 Sewage lagoon 11 Fuel storage 15 Oil well/Gas well  
 3 Watertight sewer lines 6 Seepage pit 9 Feedyard 12 Fertilizer storage 16 Other (specify below)  
 13 Insecticide storage None

Direction from well? How many feet?

FROM	TO	LITHOLOGIC LOG	FROM	TO	LITHOLOGIC LOG
0.0	4.0	Gray Brown Silty Clay-Limestone Gravel			
4.0	19.0	Gray Brown Shale-Limestone Gravel			
19.0	28.5	Dark Gray Shale			
28.5	30.0	Weathered Limestone			
30.0	39.5	Gray Brown Silty Clay			
		TD 39.5			

7 CONTRACTOR'S OR LANDOWNER'S CERTIFICATION: This water well was (1) constructed, (2) reconstructed, or (3) plugged under my jurisdiction and was completed on (mo/day/year) 6-6-86 and this record is true to the best of my knowledge and belief. Kansas Water Well Contractor's License No. 416 This Water Well Record was completed on (mo/day/yr) 6-16-86 under the business name of Terracon Consultants, SE Inc. by (signature)