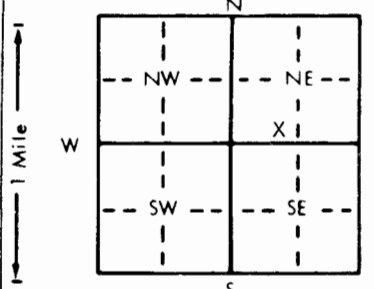


1) LOCATION OF WATER WELL: Fraction SE 1/4 SW 1/4 NE 1/4 Section Number 26 Township Number T 9 S Range Number R 11 EW
 County: Pottawatomie

Distance and direction from nearest town or city street address of well if located within city?
Dam Station 7+00, 20' LT

2) WATER WELL OWNER: K.P.L.
 RR#, St. Address, Box # : 818 Kansas Avenue Board of Agriculture, Division of Water Resources
 City, State, ZIP Code : Topeka, KS 66612 Application Number:


3) LOCATE WELL'S LOCATION WITH AN "X" IN SECTION BOX:  4) DEPTH OF COMPLETED WELL: 29.3 ft. ELEVATION: 976.0
 Depth(s) Groundwater Encountered 1. Dry ft. 2. ft. 3. ft.
 WELL'S STATIC WATER LEVEL Dry ft. below land surface measured on mo/day/yr 9-11-85
 Pump test data: Well water was ft. after hours pumping gpm
 Est. Yield gpm: Well water was ft. after hours pumping gpm
 Bore Hole Diameter: 6.5 in. to 19.3 ft., and 4.5 in. to 29.3 ft.
 WELL WATER TO BE USED AS: 5 Public water supply 8 Air conditioning 11 Injection well
 1 Domestic 3 Feedlot 6 Oil field water supply 9 Dewatering 12 Other (Specify below)
 2 Irrigation 4 Industrial 7 Lawn and garden only 10 Observation well
 Was a chemical/bacteriological sample submitted to Department? Yes No X; If yes, mo/day/yr sample was submitted
 Water Well Disinfected? Yes No X

5) TYPE OF BLANK CASING USED: 5 Wrought iron 8 Concrete tile CASING JOINTS: Glued Clamped
1 Steel * 3 RMP (SR) 6 Asbestos-Cement 9 Other (specify below) Welded
2 PVC ** 4 ABS 7 Fiberglass Threaded
 Blank casing diameter 4* in. to 25.3 ft. Dia 1** in. to 26.3 ft. Dia in. to ft.
 Casing height above land surface 5.0*/3.9** in., weight Standard Galvanized* lbs./ft. Wall thickness or gauge No. Sch. 40**
 TYPE OF SCREEN OR PERFORATION MATERIAL: 7 PVC 10 Asbestos-cement
 1 Steel 3 Stainless steel 5 Fiberglass 8 RMP (SR) 11 Other (specify)
 2 Brass 4 Galvanized steel 6 Concrete tile 9 ABS 12 None used (open hole)
 SCREEN OR PERFORATION OPENINGS ARE: 5 Gauzed wrapped 8 Saw cut 11 None (open hole)
 1 Continuous slot 3 Mill slot 6 Wire wrapped 9 Drilled holes
 2 Louvered shutter 4 Key punched 7 Torch cut 10 Other (specify) 60 Micron Casagrande
 SCREEN-PERFORATED INTERVALS: From 26.3 ft. to 28.3 ft. From ft. to ft.
 GRAVEL PACK INTERVALS: From 25.3 ft. to 29.3 ft. From ft. to ft.

6) GROUT MATERIAL: 1 Neat cement 2 Cement grout 3 Bentonite 4 Other
 Grout Intervals: From 19.6 ft. to 20.9 ft. From 21.9 ft. to 23.0 ft. From 24.0 ft. to 25.3 ft.
 What is the nearest source of possible contamination:
 1 Septic tank 4 Lateral lines 7 Pit privy 10 Livestock pens 14 Abandoned water well
 2 Sewer lines 5 Cess pool 8 Sewage lagoon 11 Fuel storage 15 Oil well/Gas well
 3 Watertight sewer lines 6 Seepage pit 9 Feedyard 12 Fertilizer storage 16 Other (specify below)
 13 Insecticide storage Unknown

Direction from well? How many feet?

FROM	TO	LITHOLOGIC LOG	FROM	TO	LITHOLOGIC LOG
0	29.3	Red Gray Brown Silty Clay Fill			

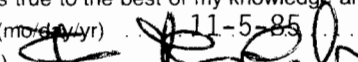7) CONTRACTOR'S OR LANDOWNER'S CERTIFICATION: This water well was 1 constructed, (2) reconstructed, or (3) plugged under my jurisdiction and was completed on (mo/day/year) 9-11-85 and this record is true to the best of my knowledge and belief. Kansas Water Well Contractor's License No. 416 This Water Well Record was completed on (mo/day/yr) 11-5-85 under the business name of Terracon Consultants SE, Inc. by (signature) 

INSTRUCTIONS: Use typewriter or ball point pen, PLEASE PRESS FIRMLY and PRINT clearly. Please fill in blanks, underline or circle the correct answers. Send top three copies to Kansas Department of Health and Environment, Division of Environment, Environmental Geology Section, Topeka, KS 66620. Send one to WATER WELL OWNER and retain one for your records.