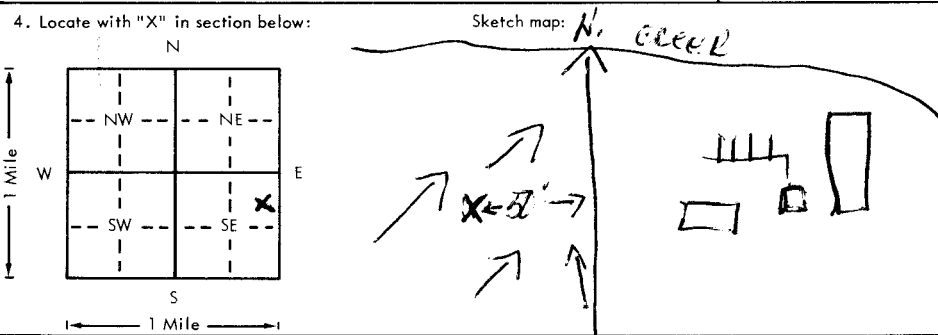


USE TYPEWRITER OR BALL POINT PEN—PRESS FIRMLY, PRINT CLEARLY.

WATER WELL RECORD  
KSA 82a-1201-1215

Kansas Department of Health and Environment—Division of Environment  
(Water well Contractors)  
Topeka, Kansas 66620

1. Location of well: County: <u>Pottawatomie</u>		Fraction: <u>E 1/4 NE 1/4 SE 1/4</u>		Section number: <u>29</u>		Township number: <u>T 9 S R 11 E/W</u>		Range number: <u>11</u>	
2. Distance and direction from nearest town or city: <u>3 3/4 miles North of Belvue, Ks.</u> Street address of well location if in city:				3. Owner of well: <u>Joe Straub</u> R.R. or street: City, state, zip code: <u>Belvue, Ks. 66407</u>					
4. Locate with "X" in section below: 				6. Bore hole dia. <u>30</u> in. Completion date <u>12-7-76</u> Well depth <u>56</u> ft.					
				7. <input type="checkbox"/> Cable tool <input type="checkbox"/> Rotary <input type="checkbox"/> Driven <input type="checkbox"/> Dug <input type="checkbox"/> Hollow rod <input type="checkbox"/> Jetted <input type="checkbox"/> Bored <input checked="" type="checkbox"/> Reverse rotary					
				8. Use: <input type="checkbox"/> Domestic <input type="checkbox"/> Public supply <input type="checkbox"/> Industry <input checked="" type="checkbox"/> Irrigation <input type="checkbox"/> Air conditioning <input type="checkbox"/> Stock <input type="checkbox"/> Lawn <input type="checkbox"/> Oil field water <input type="checkbox"/> Other					
				9. Casing: Material <u>Transite</u> Height: ( <u>Above</u> or below) <u>12</u> in. Threaded <input type="checkbox"/> Welded <input type="checkbox"/> Surface <input type="checkbox"/> RMP <input type="checkbox"/> PVC <input type="checkbox"/> Weight _____ lbs./ft. Dia. <u>16</u> in. to <u>30</u> ft. depth Wall Thickness: inches or Dia. _____ in. to _____ ft. depth gage No. <u>7/8</u>					
5. Type and color of material				From		To		10. Screen: Manufacturer's name <u>Johnson Well</u>	
<u>Top soil</u>				<u>0</u>		<u>3</u>		Type <u>Transite</u> Dia. <u>16</u> ( <u>Slo</u> ) gauze <u>1/8x8</u> Length <u>26'</u> Set between <u>30</u> ft. and <u>56</u> ft. ft. and _____ ft.	
<u>Hard black gumbo</u>				<u>3</u>		<u>8</u>		Gravel pack? <u>yes</u> Size range of material <u>5/8</u>	
<u>Med. to hard brown clay</u>				<u>8</u>		<u>25</u>		11. Static water level: _____ mo./day/yr. <u>26</u> ft. below land surface Date <u>12-7-76</u>	
<u>Soft gray clay &amp; med. mixed gravel</u>				<u>25</u>		<u>30</u>		12. Pumping level below land surfaces: <u>32</u> ft. after <u>1</u> hrs. pumping <u>1000</u> g.p.m. <u>35</u> ft. after <u>3</u> hrs. pumping <u>1200</u> g.p.m. Estimated maximum yield _____ <u>1750</u> g.p.m.	
<u>Med. green gravel</u>				<u>30</u>		<u>33</u>		13. Water sample submitted: _____ mo./day/yr. <input type="checkbox"/> Yes <input checked="" type="checkbox"/> No Date _____	
<u>Med. to large green gravel</u>				<u>33</u>		<u>35</u>		14. Well head completion: <input type="checkbox"/> Pitless adapter _____ inches above grade	
<u>Fine green gravel</u>				<u>35</u>		<u>37</u>		15. Well grouted? <u>yes</u> With: <input type="checkbox"/> Neat cement <input type="checkbox"/> Bentonite <input checked="" type="checkbox"/> Concrete Depth: From <u>0</u> ft. to <u>10</u> ft.	
<u>Med. to large light green gravel</u>				<u>37</u>		<u>38</u>		16. Nearest source of possible contamination: _____ ft. _____ Direction <u>east</u> Type <u>lateral</u> Well disinfected upon completion? <input type="checkbox"/> Yes <input checked="" type="checkbox"/> No	
<u>Med. to large brown gravel</u>				<u>38</u>		<u>56</u>		17. Pump: <input checked="" type="checkbox"/> Not installed Manufacturer's name _____ Model number _____ HP _____ Volts _____ Length of drop pipe _____ ft. capacity _____ g.p.m. Type: <input type="checkbox"/> Submersible <input type="checkbox"/> Turbine <input type="checkbox"/> Jet <input type="checkbox"/> Reciprocating <input type="checkbox"/> Centrifugal <input type="checkbox"/> Other	
<u>Large rock-stopped.</u>				<u>56</u>				20. Water well contractor's certification: This well was drilled under my jurisdiction and this report is true to the best of my knowledge and belief. <u>Hoobler Drilling Co.</u> <u>323</u> Business name _____ License No. _____ Address <u>St. Marys, Ks. 66536</u> Signed <u>Don Hoobler</u> Date <u>12-23-76</u> Authorized representative	
18. Elevation: _____				19. Remarks: <u>We do not install pumps.</u>					
Topography: <input type="checkbox"/> Hill <input type="checkbox"/> Slope <input type="checkbox"/> Upland <input checked="" type="checkbox"/> Valley									