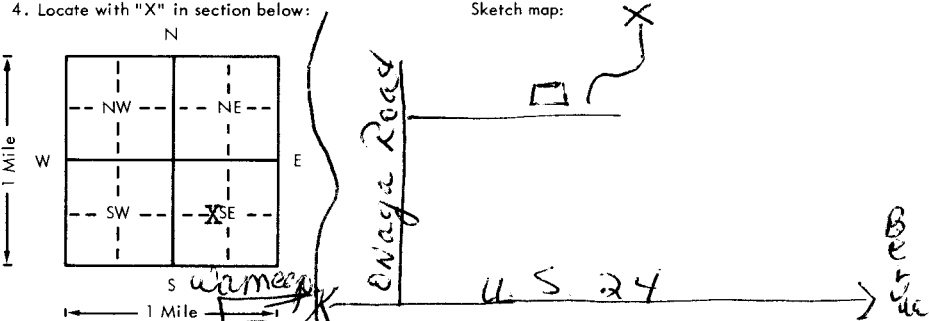


1. Location of well:		County Pottawatomie	Fraction E¹/₂ 1/4 W¹/₂ 1/4 Se¹/₄ 1/4	Section number 30	Township number T 9 S	Range number R 11 E/W	
2. Distance and direction from nearest town or city: 3 miles East & 1 1/2 miles North of Wamego, Ks.			3. Owner of well: Leo Peddicord R.R. or street: City, state, zip code: Wamego, Kansas	
4. Locate with "X" in section below: 			6. Bore hole dia. 30 in. Completion date 4-21-76 Well depth 60 ft.	
5. Type and color of material			7. <input type="checkbox"/> Cable tool <input type="checkbox"/> Rotary <input type="checkbox"/> Driven <input type="checkbox"/> Dug <input type="checkbox"/> Hollow rod <input type="checkbox"/> Jetted <input type="checkbox"/> Bored <input checked="" type="checkbox"/> Reverse rotary	
			8. Use: <input type="checkbox"/> Domestic <input type="checkbox"/> Public supply <input type="checkbox"/> Industry <input checked="" type="checkbox"/> Irrigation <input type="checkbox"/> Air conditioning <input type="checkbox"/> Stock <input type="checkbox"/> Lawn <input type="checkbox"/> Oil field water <input type="checkbox"/> Other	
			9. Casing: Material Transite Height: Above or below Threaded <input type="checkbox"/> Welded <input type="checkbox"/> Surface <input type="checkbox"/> 12 in. RMP <input type="checkbox"/> PVC <input type="checkbox"/> Weight <input type="checkbox"/> lbs./ft. Dia. 16 in. to 34 ft. depth <input checked="" type="checkbox"/> Well Thickness: inches or Dia. <input type="checkbox"/> in. to <input type="checkbox"/> ft. depth <input type="checkbox"/> gage No. 175	
			10. Screen: Manufacturer's name Johnson Type Transite Dia. 16" Sieve/gauze 1/8x8 Length 26' Set between 60 ft. and 34 ft. ft. and <input type="checkbox"/> ft. Gravel pack? yes Size range of material 5/8	
<table border="1" style="width:100%; border-collapse: collapse;"> <thead> <tr> <th></th> <th>From</th> <th>To</th> </tr> </thead> <tbody> <tr><td>Black top soil</td><td>0</td><td>4</td></tr> <tr><td>Soft gray clay</td><td>4</td><td>6</td></tr> <tr><td>Soft Brown Clay</td><td>6</td><td>24</td></tr> <tr><td>Small brown sand</td><td>24</td><td>27</td></tr> <tr><td>Small brown gravel</td><td>27</td><td>30</td></tr> <tr><td>Medium & large brown gravel</td><td>30</td><td>32</td></tr> <tr><td>Large gravel & large rocks</td><td>32</td><td>33</td></tr> <tr><td>Medium green gravel</td><td>33</td><td>38</td></tr> <tr><td>Small green gravel</td><td>38</td><td>40</td></tr> <tr><td>Medium green gravel</td><td>40</td><td>47</td></tr> <tr><td>Medium green gravel & large rock</td><td>47</td><td>48</td></tr> <tr><td>Medium green gravel & large rock</td><td>48</td><td>55</td></tr> <tr><td>Medium green gravel & large rock</td><td>55</td><td>57</td></tr> <tr><td>Medium brown gravel & large rock</td><td>57</td><td>60</td></tr> <tr><td>Large rocks-stopped.</td><td>60</td><td></td></tr> </tbody> </table>				From	To	Black top soil	0	4	Soft gray clay	4	6	Soft Brown Clay	6	24	Small brown sand	24	27	Small brown gravel	27	30	Medium & large brown gravel	30	32	Large gravel & large rocks	32	33	Medium green gravel	33	38	Small green gravel	38	40	Medium green gravel	40	47	Medium green gravel & large rock	47	48	Medium green gravel & large rock	48	55	Medium green gravel & large rock	55	57	Medium brown gravel & large rock	57	60	Large rocks-stopped.	60		11. Static water level: <input type="checkbox"/> mo./day/yr. 18 ft. below land surface Date 4-21-76	
12. Pumping level below land surfaces: 23 ft. after 1 hrs. pumping 1000 g.p.m. 29 ft. after 3 hrs. pumping 1600 g.p.m. Estimated maximum yield 2000 g.p.m.	
13. Water sample submitted: <input type="checkbox"/> Yes <input checked="" type="checkbox"/> No Date <input type="checkbox"/>	
14. Well head completion: <input type="checkbox"/> Pitless adapter <input type="checkbox"/> Inches above grade	
15. Well grouted? yes With: <input type="checkbox"/> Neat cement <input type="checkbox"/> Bentonite <input checked="" type="checkbox"/> Concrete Depth: From 0 ft. to 10 ft.	
16. Nearest source of possible contamination: ft. 500 Direction South Type Feedlot Well disinfected upon completion? <input type="checkbox"/> Yes <input type="checkbox"/> No	
17. Pump: <input checked="" type="checkbox"/> Not installed Manufacturer's name <input type="checkbox"/> Model number <input type="checkbox"/> HP <input type="checkbox"/> Volts <input type="checkbox"/> Length of drop pipe <input type="checkbox"/> ft. capacity <input type="checkbox"/> g.p.m. Type: <input type="checkbox"/> Submersible <input type="checkbox"/> Turbine <input type="checkbox"/> Jet <input type="checkbox"/> Reciprocating <input type="checkbox"/> Centrifugal <input type="checkbox"/> Other	
20. Water well contractor's certification: This well was drilled under my jurisdiction and this report is true to the best of my knowledge and belief. Hoobler Drilling Co. 323 Business name License No. Address St. Marys, Ks. 66536 Signed Dan Hoobler Date 4-27-76 Authorized representative	
18. Elevation:		19. Remarks:		20. Water well contractor's certification:	
Topography: <input type="checkbox"/> Hill <input type="checkbox"/> Slope <input checked="" type="checkbox"/> Upland <input checked="" type="checkbox"/> Valley	