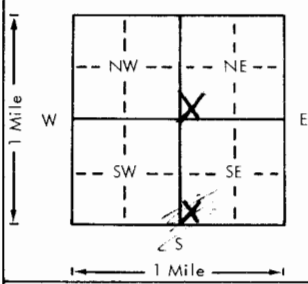


USE TYPEWRITER OR BALL  
POINT PEN-PRESS FIRMLY,  
PRINT CLEARLY.

WATER WELL RECORD  
KSA 82a-1201-1215

Kansas Department of Health and  
Environment-Division of Environment  
(Water well Contractors)  
Topeka, Kansas 66620

1. Location of well:		County <u>Pottawatomie</u>	Fraction <u>SW 1/4 SW 1/4 NE 1/4</u>	Section number <u>32</u>	Township number <u>T 9 S R 11 E</u>	Range number <u>11</u>
2. Distance and direction from nearest town or city: <u>1 1/2 E - 1 N - 1/2 W</u>		3. Owner of well: <u>Robert L. Peddicord</u> <u>1600 Sunset</u> City, state, zip code: <u>Hamego, Kansas 66547</u>				
4. Locate with "X" in section below:		Sketch map:		6. Bore hole dia. <u>3.2</u> in. Completion date <u>11-25-78</u> Well depth <u>78</u> ft.		
				7. Cable tool <input type="checkbox"/> Rotary <input type="checkbox"/> Driven <input type="checkbox"/> Dug <input type="checkbox"/> Hollow rod <input type="checkbox"/> Jetted <input type="checkbox"/> Bored <input checked="" type="checkbox"/> Reverse rotary		
5. Type and color of material		From		To		8. Use: <input type="checkbox"/> Domestic <input type="checkbox"/> Public supply <input type="checkbox"/> Industry <input checked="" type="checkbox"/> Irrigation <input type="checkbox"/> Air conditioning <input type="checkbox"/> Stock <input type="checkbox"/> Lawn <input type="checkbox"/> Oil field water <input type="checkbox"/> Other
<u>top soil + clay</u>		<u>0</u>		<u>23</u>		9. Casing: Material <u>AC</u> Height Above or below surface <u>12</u> in. Threaded <input type="checkbox"/> Welded <input type="checkbox"/> RMP <input type="checkbox"/> PVC <input type="checkbox"/> Weight <u>34</u> lbs./ft. Dia. <u>16</u> in. to <u>78</u> ft. depth Wall Thickness: inches or <u>3/4</u>
<u>sand</u>		<u>23</u>		<u>28</u>		10. Screen: Manufacturer's name <u>Johnson Controls</u> Type <u>Transite</u> Dia. <u>16</u> Slot/groove <u>78</u> Length <u>26</u> Set between <u>65</u> ft. and <u>78</u> ft. <u>52</u> ft. and <u>65</u> ft. Gravel pack? <u>YES</u> Size range of material <u>5/8</u>
<u>gravel</u>		<u>28</u>		<u>40</u>		11. Static water level: <u>28</u> ft. below land surface Date <u>10-28-78</u> mo./day/yr.
<u>sand</u>		<u>40</u>		<u>44</u>		12. Pumping level below land surfaces: <u>40</u> ft. after <u>1</u> hrs. pumping <u>1250</u> g.p.m. ft. after hrs. pumping g.p.m. Estimated maximum yield <u>2000</u> g.p.m.
<u>gravel</u>		<u>44</u>		<u>82</u>		13. Water sample submitted: <u>YES</u> No <input checked="" type="checkbox"/> Date
						14. Well head completion: Pitless adapter <u>12</u> Inches above grade
						15. Well grouted? <u>YES</u> With: <input type="checkbox"/> Neat cement <input type="checkbox"/> Bentonite <input checked="" type="checkbox"/> Concrete Depth: From <u>0</u> ft. to <u>10</u> ft.
						16. Nearest source of possible contamination: <u>NONE</u> ft. Direction Type Well disinfected upon completion? <input type="checkbox"/> Yes <input checked="" type="checkbox"/> No
						17. Pump: <input type="checkbox"/> Not installed Manufacturer's name <u>WLR</u> Model number <u>81M</u> HP <u>30</u> Volts <u>230</u> Length of drop pipe <u>70</u> ft. capacity <u>1200</u> g.p.m. Type: <input type="checkbox"/> Submersible <input checked="" type="checkbox"/> Turbine <input type="checkbox"/> Jet <input type="checkbox"/> Reciprocating <input type="checkbox"/> Centrifugal <input type="checkbox"/> Other
18. Elevation:		19. Remarks:		20. Water well contractor's certification:		
Topography: <input type="checkbox"/> Hill <input type="checkbox"/> Slope <input type="checkbox"/> Upland <input checked="" type="checkbox"/> Valley		<u>Final total completion will be done after snow is gone</u>		This well was drilled under my jurisdiction and this report is true to the best of my knowledge and belief. <u>Cox-Beswick</u> <u>361</u> Business name License No. Address <u>Chilton, Kansas</u> Signed <u>Francis Cox</u> Date <u>11-2</u> Authorized representative		