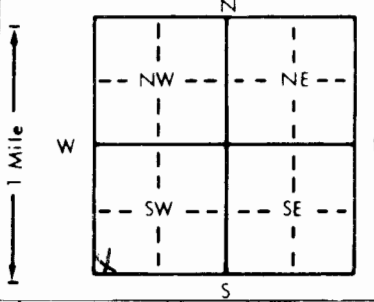


1 LOCATION OF WATER WELL: County: Pottawatomie Fraction SW 1/4 SW 1/4 SW 1/4 Section Number 34 Township Number T 9 S Range Number R 11 **EXX**

Distance and direction from nearest town or city street address of well if located within city?
Approximately 525' west of Intersection of Broadway and 6th Street, Belvue, KS

2 WATER WELL OWNER: City of Belvue
 RR#, St. Address, Box #: City Hall Box 27 Board of Agriculture, Division of Water Resources
 City, State, ZIP Code: Belvue, KS 66407 Application Number: 39,672

3 LOCATE WELL'S LOCATION WITH AN "X" IN SECTION BOX:

 4 DEPTH OF COMPLETED WELL: 72 ft. ELEVATION: unknown
 Depth(s) Groundwater Encountered: 1. _____ ft. 2. _____ ft. 3. _____ ft.
 WELL'S STATIC WATER LEVEL: 16 ft. below land surface measured on mo/day/yr
 Pump test data: Well water was not ch'd ft. after _____ hours pumping _____ gpm
 Est. Yield unknown gpm: Well water was _____ ft. after _____ hours pumping _____ gpm
 Bore Hole Diameter: 30 in. to 70 ft., and _____ in. to _____ ft.
 WELL WATER TO BE USED AS:
 5 Public water supply 8 Air conditioning 11 Injection well
 1 Domestic 3 Feedlot 6 Oil field water supply 9 Dewatering 12 Other (Specify below)
 2 Irrigation 4 Industrial 7 Lawn and garden only 10 Monitoring well
 Was a chemical/bacteriological sample submitted to Department? Yes X No _____; If yes, mo/day/yr sample was submitted sampled by Reiss & Goodness while test pumping Water Well Disinfected? Yes X No _____

5 TYPE OF BLANK CASING USED:
 1 Steel 3 RMP (SR) 6 Asbestos-Cement 9 Other (specify below) Welded X
 2 PVC 4 ABS 7 Fiberglass _____ Threaded _____
 Blank casing diameter: 10 in. to 40 ft., Dia _____ in. to _____ ft., Dia _____ in. to _____ ft.
 Casing height above land surface: 24 in., weight 40.48 lbs./ft. Wall thickness or gauge No. 365

TYPE OF SCREEN OR PERFORATION MATERIAL:
 1 Steel 3 Stainless steel 5 Fiberglass 8 RMP (SR) 11 Other (specify) _____
 2 Brass 4 Galvanized steel 6 Concrete tile 9 ABS 12 None used (open hole)

SCREEN OR PERFORATION OPENINGS ARE:
 1 Continuous slot 3 Mill slot 6 Wire wrapped 9 Drilled holes
 2 Louvered shutter 4 Key punched 7 Torch cut 10 Other (specify) _____

SCREEN-PERFORATED INTERVALS: From 40 ft. to 70 ft., From _____ ft. to _____ ft.
 From _____ ft. to _____ ft., From _____ ft. to _____ ft.
 GRAVEL PACK INTERVALS: From 38 ft. to 70 ft., From _____ ft. to _____ ft.
 From _____ ft. to _____ ft., From _____ ft. to _____ ft.

6 GROUT MATERIAL: 1 Neat cement 2 Cement grout 3 Bentonite 4 Other 50% fine sand, 50% Bentonite
 Grout Intervals: From 6 ft. to 20 ft., From _____ ft. to _____ ft., From 20 ft. to 38 ft.
 What is the nearest source of possible contamination:
 1 Septic tank 4 Lateral lines 7 Pit privy 10 Livestock pens 14 Abandoned water well
 2 Sewer lines 5 Cess pool 8 Sewage lagoon 11 Fuel storage 15 Oil well/Gas well
 3 Watertight sewer lines 6 Seepage pit 9 Feedyard 12 Fertilizer storage 16 Other (specify below)
 13 Insecticide storage none known

Direction from well? _____ How many feet? _____

FROM	TO	LITHOLOGIC LOG	FROM	TO	PLUGGING INTERVALS
0	4	Topsoil			
4	13	Clay, dark brown			
13	22	Sand and Gravel, fine, medium			
22	33	Sand and Gravel, gray, fine medium			
33	39	Sand and Gravel, fine, medium, coarse, loose			
39	41	Sand, very fine to fine			
41	70	Gravel, fine, medium with flat cobble			
	70	Shale			

7 CONTRACTOR'S OR LANDOWNER'S CERTIFICATION: This water well was (1) constructed, (2) reconstructed, or (3) plugged under my jurisdiction and was completed on (mo/day/year) 12-20-89 and this record is true to the best of my knowledge and belief. Kansas Water Well Contractor's License No. 185 This Water Well Record was completed on (mo/day/yr) 12-28-89 under the business name of Clarke Well & Equipment, Inc. by (signature) Clarke Well & Equipment