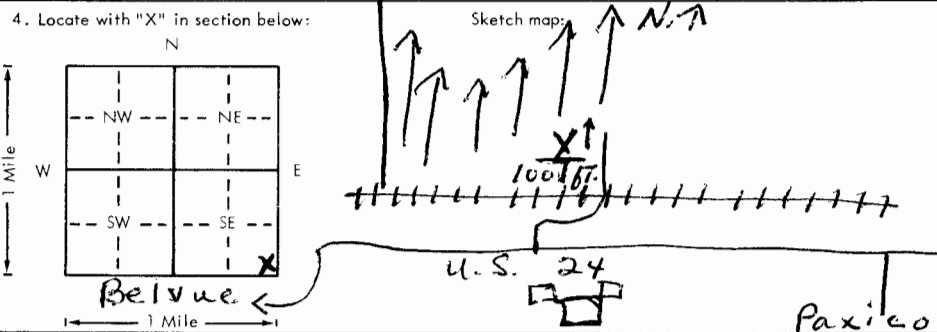


USE TYPEWRITER OR BALL POINT PEN—PRESS FIRMLY, PRINT CLEARLY.

WATER WELL RECORD
KSA 82a-1201-1215

Kansas Department of Health and Environment—Division of Environment
(Water well Contractors)
Topeka, Kansas 66620

1. Location of well:		County Pottawatomie	Fraction SE 1/4 SE 1/4 SE 1/4	Section number 35	Township number T 9 S R 11 E/W	Range number 11
2. Distance and direction from nearest town or city: 2 mi. East of Belvue, Ks. on U.S. 24. Street address of well location if in city:				3. Owner of well: Wolff Foundation R.R. or street: 1st. Nat'l. Bank-Trust Dept. Bx. 88 City, state, zip code: Topeka, Kansas 66601		
4. Locate with "X" in section below: 				6. Bore hole dia. 30 in. Completion date 5-1-77 Well depth 53 ft.		
5. Type and color of material				7. <input type="checkbox"/> Cable tool <input type="checkbox"/> Rotary <input type="checkbox"/> Driven <input type="checkbox"/> Dug <input type="checkbox"/> Hollow rod <input type="checkbox"/> Jetted <input type="checkbox"/> Bored <input checked="" type="checkbox"/> Reverse rotary		
				8. Use: <input type="checkbox"/> Domestic <input type="checkbox"/> Public supply <input type="checkbox"/> Industry <input checked="" type="checkbox"/> Irrigation <input type="checkbox"/> Air conditioning <input type="checkbox"/> Stock <input type="checkbox"/> Lawn <input type="checkbox"/> Oil field water <input type="checkbox"/> Other		
				9. Casing: Material Steel Height (Above or below surface) 12 in. Threaded <input type="checkbox"/> Welded yes RMP <input type="checkbox"/> PVC <input type="checkbox"/> Weight _____ lbs./ft. Dia 16 in. to 33 ft. depth Wall Thickness: inches or gage No. 219 w.t.		
				10. Screen: Manufacturer's name Free-Flo W. A. Brown Enterprises Type steel Dia. 16" Slot/gauze 1/8 x 2 Length 20' Set between X 3 ft. and X 33 ft. ft. and _____ ft. Gravel pack? yes size range of material 1/8-1/4		
				11. Static water level: _____ mo./day/yr. 23 1/2 ft. below land surface Date 5-1-77		
				12. Pumping level below land surfaces: 32 1/2 ft. after 1 hrs. pumping 800 g.p.m. 43 1/2 ft. after 3 hrs. pumping 1200 g.p.m. Estimated maximum yield 1200 g.p.m.		
				13. Water sample submitted: _____ mo./day/yr. <input type="checkbox"/> Yes <input checked="" type="checkbox"/> No Date _____		
				14. Well head completion: <input type="checkbox"/> Pitless adapter _____ Inches above grade		
				15. Well grouted? yes With: <input type="checkbox"/> Neat cement <input type="checkbox"/> Bentonite <input checked="" type="checkbox"/> Concrete Depth: From 0 ft. to 10 ft.		
				16. Nearest source of possible contamination: ft 100 Direction south Type railroad Well disinfected upon completion? <input type="checkbox"/> Yes <input checked="" type="checkbox"/> No		
				17. Pump: <input checked="" type="checkbox"/> Not installed Manufacturer's name _____ Model number _____ HP _____ Volts _____ Length of drop pipe _____ ft. capacity _____ g.p.m. Type: <input type="checkbox"/> Submersible <input type="checkbox"/> Turbine <input type="checkbox"/> Jet <input type="checkbox"/> Reciprocating <input type="checkbox"/> Centrifugal <input type="checkbox"/> Other		
(Use a second sheet if needed)						
18. Elevation:		19. Remarks: Leveled for flood irrigation. We do not install pumps.		20. Water well contractor's certification: This well was drilled under my jurisdiction and this report is true to the best of my knowledge and belief. Hoobler Drilling Co. 323 Business name License No. _____ Address St. Marys, Ks. 66536 Signed Don Hoobler Date 5-16-77 Authorized representative		
Topography: <input type="checkbox"/> Hill <input type="checkbox"/> Slope <input type="checkbox"/> Upland <input checked="" type="checkbox"/> Valley						