


USE TYPEWRITER OR BALL POINT PEN-PRESS FIRMLY, PRINT CLEARLY.

WATER WELL RECORD
KSA 82a-1201-1215

Kansas Department of Health and Environment-Division of Environment (Water well Contractors) Topeka, Kansas 66620

1. Location of well: County **Pottawatomie** Fraction **1/4 SW 1/4 SE 1/4** Section number **35** Township number **T 9 S R 11 E XX** Range number

2. Distance and direction from nearest town or city: **1 1/2 Miles East of Belvue on U.P.R.R.** Street address of well location if in city:
 3. Owner of well: **Kansas Power & Light Co.** R.R. or street: **818 Kansas Ave.** City, state, zip code: **Topeka, Kansas 66601**

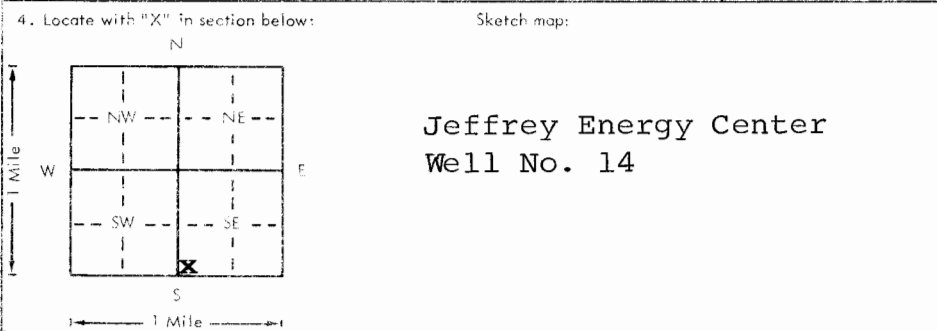

6. Bore hole dia. **48** in. Completion date **8/15/78**
 Well depth **40** ft.
 7. Cable tool Rotary Driven Dug Hollow rod Jetted Bored Reverse rotary
 8. Use: Domestic Public supply Industry Irrigation Air conditioning Stock Lawn Oil field water Other
 9. Casing: Material **steel** Height: Above **XXXX**
 Threaded Welded Surface **60** in.
 RMP PVC Weight **70.6** lbs./ft.
 Dia. **18** in. to **20** ft. depth Wall Thickness: inches
 Dia. in. to ft. depth gage No. **0.375"**

5. Type and color of material	From	To
Soil	0	3
Brown clay	3	15
Med. to coarse sand & gravel	15	30
Blue clay	30	32
Med. to coarse sand & gravel w/boulders	32	42
Blue clay	42	43
Med. to coarse sand & gravel w/boulders	43	46
Shale	46	

10. Screen: Manufacturer's name **Layne**
 Type **W.W.** Dia. **30"**
 Slot/gauze **100** Length **20"**
 Set between **20** ft. and **40** ft.
 Gravel pack? **yes** Size range of material **1/8 x 3/8"**
 11. Static water level: **15** ft. below land surface Date **4/8/78**
 12. Pumping level below land surfaces:
26 ft. after **8** hrs. pumping **640** g.p.m.
 _____ ft. after _____ hrs. pumping _____ g.p.m.
 Estimated maximum yield **800** g.p.m.
 13. Water sample submitted: _____ mc./day/yr.
 Yes No Date _____
 14. Well head completion: _____ Pitless adapter _____ inches above grade
 15. Well grouted? **Yes**
 With: Neat cement Bentonite Concrete _____
 Depth: From **0** ft. to **20** ft.
 16. Nearest source of possible contamination: **ND***
 ft. _____ Direction _____ Type _____
 Well disinfected upon completion? Yes No
 17. Pump: _____ Not installed
 Manufacturer's name **Layne**
 Model number **10 RKEH** HP **125** Volts **460**
 Length of drop pipe **35** ft. capacity **500** g.p.m.
 Type: _____ Submersible Turbine _____ Jet _____ Reciprocating _____ Centrifugal _____ Other _____

18. Elevation: **+ 959'**
 Topography: _____ Hill _____ Slope _____ Upland _____ Valley
 19. Remarks: ***Not Determined**

20. Water well contractor's certification: This well was drilled under my jurisdiction and this report is true to the best of my knowledge and belief.
Layne Western Co. **102**
 Business name License No.
 Address **Wichita, Kansas**
 Signed **[Signature]** Date **8-16-78**
 Authorized representative