


1 LOCATION OF WATER WELL: Fraction SE 1/4 NE 1/4 Section Number 35 Township Number T 9 S Range Number R 11 EW  
 County: Pottawatomie

Distance and direction from nearest town or city street address of well if located within city?  
SW 1 1/2 Miles Belvue KS 66407

2 WATER WELL OWNER: National Bank of Topeka Wolff Trust  
 RR#, St. Address, Box #: P.O. Box 88 Board of Agriculture, Division of Water Resources  
 City, State, ZIP Code: Topeka, KS 66601 Application Number:

3 LOCATE WELL'S LOCATION WITH AN "X" IN SECTION BOX:

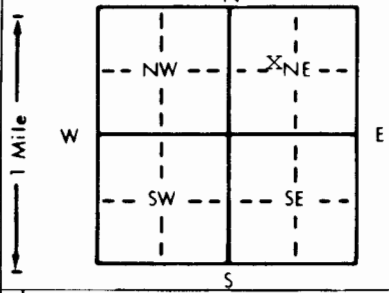

4 DEPTH OF COMPLETED WELL 38.5' ft. ELEVATION:  
 Depth(s) Groundwater Encountered 1.19' ft. 2. ft. 3. ft.  
 WELL'S STATIC WATER LEVEL .19' ft. below land surface measured on mo/day/yr 09/17/92  
 Pump test data: Well water was ft. after hours pumping gpm  
 Est. Yield gpm: Well water was ft. after hours pumping gpm  
 Bore Hole Diameter in. to ft., and in. to ft.  
 WELL WATER TO BE USED AS:  
 1 Domestic  2 Irrigation  3 Feedlot  4 Industrial  5 Public water supply  6 Oil field water supply  7 Lawn and garden only  8 Air conditioning  9 Dewatering  10 Monitoring well  11 Injection well  12 Other (Specify below)  
 Was a chemical/bacteriological sample submitted to Department? Yes  No  If yes, mo/day/yr sample was submitted  
 Water Well Disinfected?  Yes  No

5 TYPE OF BLANK CASING USED:  
 1 Steel  2 PVC  3 RMP (SR)  4 ABS  5 Wrought iron  6 Asbestos-Cement  7 Fiberglass  8 Concrete tile  9 Other (specify below)  10 Asbestos-cement  11 Other (specify)  12 None used (open hole)  
 Blank casing diameter 5 in. to ft., Dia in. to ft., Dia in. to ft.  
 Casing height above land surface in., weight lbs./ft. Wall thickness or gauge No.

TYPE OF SCREEN OR PERFORATION MATERIAL:  
 1 Steel  2 Brass  3 Stainless steel  4 Galvanized steel  5 Fiberglass  6 Concrete tile  7 PVC  8 RMP (SR)  9 ABS  10 Asbestos-cement  11 Other (specify) NA  
 SCREEN OR PERFORATION OPENINGS ARE:  
 1 Continuous slot  2 Louvered shutter  3 Mill slot  4 Key punched  5 Gauzed wrapped  6 Wire wrapped  7 Torch cut  8 Saw cut  9 Drilled holes  10 Other (specify) NA  
 SCREEN-PERFORATED INTERVALS: From NA ft. to NA ft., From ft. to ft., From ft. to ft., From ft. to ft.

GRAVEL PACK INTERVALS: From ft. to ft., From ft. to ft., From ft. to ft., From ft. to ft.  
 6 GROUT MATERIAL: 1 Neat cement  2 Cement grout  3 Bentonite  4 Other   
 Grout Intervals: From 1.7 ft. to 1.4 ft., From 6 ft. to 5.6 ft., From ft. to ft., From ft. to ft.  
 What is the nearest source of possible contamination:  
 1 Septic tank  2 Sewer lines  3 Watertight sewer lines  4 Lateral lines  5 Cess pool  6 Seepage pit  7 Pit privy  8 Sewage lagoon  9 Feedyard  10 Livestock pens  11 Fuel storage  12 Fertilizer storage  13 Insecticide storage  14 Abandoned water well  15 Oil well/Gas well  16 Other (specify below)

Direction from well? How many feet?  
 FROM TO LITHOLOGIC LOG FROM TO PLUGGING INTERVALS

FROM	TO	LITHOLOGIC LOG	FROM	TO	PLUGGING INTERVALS
			38.5'	17.0'	Medium Course Sand
			17.0	14.0'	Bentonite Feed grade
			14.0'	6'	Clay
			6.0'	5.6'	100lbs Bentonite
			5.6'	0'	Silt

CONTRACTOR'S OR LANDOWNER'S CERTIFICATION: This water well was (1) constructed, (2) reconstructed, or (3) plugged under my jurisdiction and was completed on (mo/day/year) 09/17/92 and this record is true to the best of my knowledge and belief. Kansas Water Well Contractor's License No. 09/18/92 This Water Well Record was completed on (mo/day/year) 09/18/92 under the business name of Marvin Hebert Plmg by (signature) Marvin Hebert