


1 LOCATION OF WATER WELL: Fraction $\frac{1}{4}$ $\frac{1}{4}$ NW $\frac{1}{4}$ $\frac{1}{4}$ Section Number 31 Township Number T 9 S Range Number 11 E W
 County: Pottawatomie

Street/Rural Address of Well Location: if unknown, distance & direction from nearest town or intersection: If at owner's address, check here
16795 Say Rd, Wamego, KS 66547

2 WATER WELL OWNER: U.S. Army Corps of Eng.
 RR#, St. Address, Box #: 601 East 12th ST
 City, State ZIP Code: Kansas City, MO 64106

Global Positioning Systems (GPS) information:
 Latitude: 39.222335 (in decimal degrees)
 Longitude: 96.325289 (in decimal degrees)
 Elevation: 1108.60
 Datum: WGS84, NAD83, NAD27
 Collection Method:
 GPS unit (Make/Model: iPhone 5C)
 Digital Map/Photo, Topographic Map, Land Survey
 Est. Accuracy: < 3 m, 3-5 m, 5-15 m, > 15 m

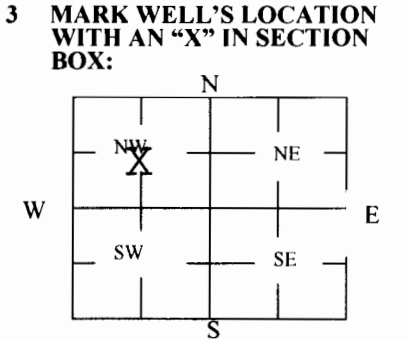

4 DEPTH OF WELL 113 ft.
 WELL'S STATIC WATER LEVEL 97.63 ft
 WELL WAS USED AS:
 Domestic Irrigation Feedlot Industrial
 Public Water Supply Oil Field Water Supply Domestic (Lawn & Garden) Air Conditioning
 Dewatering Monitoring Injection Well
 Other ISCO
 Was a chemical/bacteriological sample submitted to Department? Yes No

5 TYPE OF BLANK CASING USED:
 Steel PVC RMP (SR) ABS Wrought Asbestos-Cement Fiberglass Concrete Tile Other (Specify below) _____
 Blank casing diameter 4 in. Was casing pulled? Yes No If yes, how much _____
 Casing height above or below land surface 30 in.

6 GROUT PLUG MATERIAL: Neat cement Cement grout Bentonite Other _____
 Grout Plug Intervals: From _____ ft. to _____ ft., From _____ ft. to _____ ft., From _____ to _____ ft.
 What is the nearest source of possible contamination:
 Septic tank Sewer lines Watertight sewer lines Lateral lines Cess pool
 Seepage pit Pit privy Sewage lagoon Feedyard Livestock pens
 Fuel Storage Fertilizer storage Insecticide storage Abandoned water well Oil well/Gas well
 Other (specify below) Unknown
 Direction from well? _____
 How many feet? _____

FROM	TO	PLUGGING MATERIALS	FROM	TO	PLUGGING MATERIALS
0	113	Neat Cement			

7 CONTRACTOR'S OR LANDOWNER'S CERTIFICATION: This water well was plugged under my jurisdiction and was completed on (mo/day/year) 10-31-14 and this record is true to the best of my knowledge and belief. Kansas Water Well Contractor's License No. 597. This Water Well Record was completed on (mo/day/year) 10-31-14 under the business name of Cascade Drilling, L.P. by (signature) [Signature]

INSTRUCTIONS: Use typewriter or ballpoint pen. Please press firmly and print clearly. Please fill in blanks, underline or circle the correct answers. Send one copy to Kansas Department of Health and Environment, Bureau of Water, Geology Section, 1000 SW Jackson St., Ste. 420, Topeka, Kansas 66612-1367. Telephone: 785/296-5524. Send one to Water Well Owner and retain one for your records. Visit us at <http://www.kdheks.gov/waterwell/index.html>.